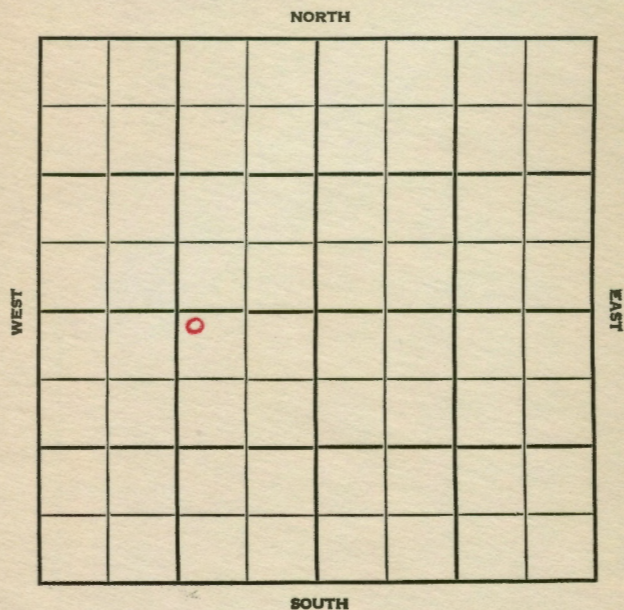


Section 6 Township 34 Range 6EWell No. #1 LesterCompany Frank Wood & Leo Fortier

SEC. 6 TWP. 34 R. 6 E

WELL NO. # 1 Lester FARM

COMPANY Frank Wood & Leo Fortier

CONTRACTOR Fortier & Wright


\_\_\_\_\_ Ft. from N. Line

\_\_\_\_\_ Ft. from S. Line

\_\_\_\_\_ Ft. from E. Line

\_\_\_\_\_ Ft. from W. Line

NW NE SW

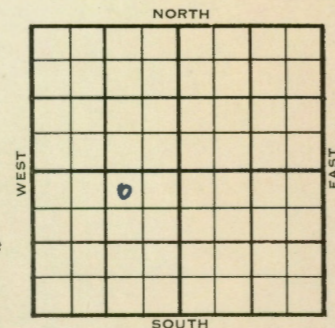

1955

ELEVATION

REPORT

6/8

Comm. 6-4-55  
8-5/8" @ 90 w/1750

6/15

D&amp;A

Tops

H. Layton 2172, 998

M. 2999, 1825

TD. 3014

ABANDONED

County Cowley Elev. 1174  
 Sec. 6 Twp. 34 Rge. 6E  
 Company Frank Wood & Leo Fortier  
 FarmName Lester No. 1

| TOPS   | DEPTH | LOG | DATUM | Loc. in Sec. |
|--------|-------|-----|-------|--------------|
| Anh.   |       |     |       | NW NE SW     |
| Tr.    |       |     |       |              |
| H.     |       |     |       |              |
| Tr.    |       |     |       |              |
| Dg.    |       |     |       |              |
| BL.    |       |     |       |              |
| L.     |       |     |       | Geol.        |
| K.C.   |       |     |       | Contr.       |
| B.K.C. |       |     |       | Fortier &    |
| Ce.    |       |     |       | Wright       |
| C.     |       |     |       | Pool         |
| M.     |       |     |       |              |
| M.     |       |     |       |              |
| K.     |       |     |       |              |
| Mz.    |       |     |       |              |
| Mo.    |       |     |       |              |
| V.     |       |     |       |              |
| S.     |       |     |       |              |
| S.     |       |     |       |              |
| A.     |       |     |       |              |
| R.     |       |     |       |              |
| Pe.    |       |     |       |              |
| G.     |       |     |       |              |
| TD.    |       |     |       |              |

FIRST REPORT  
JUN 8 55

Date Comm. 6-4-55  
8 5/8" @ 90/1750

County Cowley Elev. 1174  
 Sec. 6 Twp. 34 Rge. 6E  
 Company Frank Wood & Leo Fortier  
 FarmName Lester No. 1

| TOPS             | DEPTH       | LOG | DATUM       | Loc. in Sec. |
|------------------|-------------|-----|-------------|--------------|
| Anh.             |             |     |             | NW NE SW     |
| Tr.              |             |     |             |              |
| H. <u>Layten</u> | <u>2172</u> |     | <u>998</u>  |              |
| Tr.              |             |     |             |              |
| Dg.              |             |     |             |              |
| BL.              |             |     |             |              |
| L.               |             |     |             | Geol.        |
| K.C.             |             |     |             | Contr.       |
| B.K.C.           |             |     |             | Fortier &    |
| Ce.              |             |     |             | Wright       |
| C.               |             |     |             |              |
| M.               | <u>2999</u> |     | <u>1825</u> |              |
| M.               |             |     |             |              |
| K.               |             |     |             |              |
| Mz.              |             |     |             |              |
| Mo.              |             |     |             |              |
| V.               |             |     |             |              |
| S.               |             |     |             |              |
| S.               |             |     |             |              |
| A.               |             |     |             |              |
| R.               |             |     |             |              |
| Pe.              |             |     |             |              |
| G.               |             |     |             |              |
| TD.              | <u>3014</u> |     |             |              |

ABANDONED  
JUN 15 1955

Date Comm. 6-4-55  
8 5/8" @ 84/90

D & A