


Give All Information Completely
Make Required Affidavit
Mail or Deliver Report to:
Conservation Division
State Corporation Commission
800 Biting Building
Wichita, Kansas

NORTH

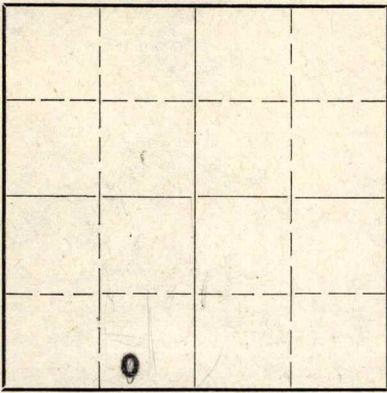

Locate well correctly on above
Section Plat

Cowley

County. Sec. 6 Twp. 34 Rge. 6 (E) (W)

Location as "NE $\frac{1}{4}$ NW $\frac{1}{4}$ SW $\frac{1}{4}$ " or footage from lines Sw. SE. of SW. $\frac{1}{4}$

Lease Owner B.B. Blair

Lease Name Lester

Well No. 1

Office Address Atlas Life Bldg. Tulsa, Okla.

Character of Well (completed as Oil, Gas or Dry Hole) Dry Hole

Date well completed 19

Application for plugging filed 19

Application for plugging approved 19

Plugging commenced Dec. 22nd. 1943 19

Plugging completed ~~1944~~ Jan. 18th. 1944 19

Reason for abandonment of well or producing formation Dry Hole

If a producing well is abandoned, date of last production 19

Was permission obtained from the Conservation Division or its agents before plugging was commenced? Yes

Name of Conservation Agent who supervised plugging of this well Wm. Lemaster

Producing formation Miss. Lime Depth to top 2924 Bottom 2954 Total Depth of Well 2954 Feet

Show depth and thickness of all water, oil and gas formations.

OIL, GAS OR WATER RECORDS

CASING RECORD

Formation	Content	From	To	Size	Put In	Pulled Out
Miss. Lime	Oil & Water	2924	2954	5 $\frac{1}{2}$ " OD 10"	2924' 50'	1395'7" None

Describe in detail the manner in which the well was plugged, indicating where the mud fluid was placed and the method or methods used in introducing it into the hold. If cement or other plugs were used, state the character of same and depth placed, from _____ feet to _____ feet for each plug set.

The above well was filled with gravel to 2927' then cement to 2900' then mud to 80' then rock to 70' then cement to 55' then mud to top of surface pipe then steel plate welded on top of surface pipe

(If additional description is necessary, use BACK of this sheet)

Correspondence regarding this well should be addressed to E.B. Blair

Address Atlas Life Bldg. Tulsa, Okla.

STATE OF _____, COUNTY OF _____, ss.

_____ (employee of owner) or (owner or operator) of the above-described well, being first duly sworn on oath, says: That I have knowledge of the facts, statements, and matters herein contained and the log of the above-described well as filed and that the same are true and correct. So help me God.

(Signature) _____

(Address)

SUBSCRIBED AND SWORN to before me this 26th day of January, 19 44

O.W.L.I

My commission expires _____

Notary Public.


Give All Information Completely
Make Required Affidavit
Mail or Deliver Report to:
Conservation Division
State Corporation Commission
800 Biting Building
Wichita, Kansas

OR

FORMATION PLUGGING RECORD

Strike out upper line
when reporting plug-
ging of formations.

NORTH

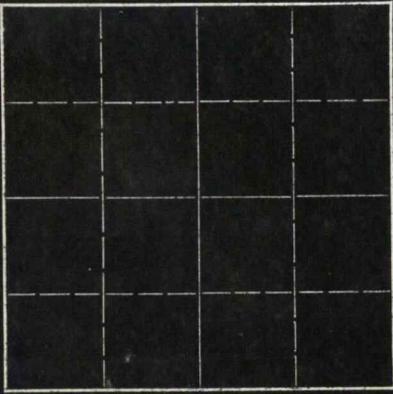

Locate well correctly on above
Section Plat

Cowley County. Sec. *6* Twp. *24* Rge. *6* (E) (W)
Location as "NE1/4 SW1/4" or footage from lines *SW1/4 SE1/4 SW1/4*
Lease Owner *B.B. Blair*
Lease Name *Lester* Well No. *1*
Office Address *Atlas Life Building Tulsa Okla*
Character of Well (completed as Oil, Gas or Dry Hole) *Dry Hole*
Date well completed..... 19.....
Application for plugging filed..... 19.....
Application for plugging approved..... 19.....
Plugging commenced..... *Dec. 22, 1943*
Plugging completed..... *Jan. 1, 1944*
Reason for abandonment of well or producing formation..... *Dry Hole*

If a producing well is abandoned, date of last production..... 19.....
Was permission obtained from the Conservation Division or its agents before plugging was com-
menced?..... *Yes*

Name of Conservation Agent who supervised plugging of this well..... *Will S. Seamanster*
Producing formation..... Depth to top..... Bottom..... Total Depth of Well..... *2954* Feet
Show depth and thickness of all water, oil and gas formations.

OIL, GAS OR WATER RECORDS

CASING RECORD

Formation	Content	From	To	Size	Put In	Pulled Out
						X

Describe in detail the manner in which the well was plugged, indicating where the mud fluid was placed and the method or methods used in introducing it into the hold. If cement or other plugs were used, state the character of same and depth placed, from.....feet to.....feet for each plug set.

Gravel 2954 to 2927'
Cement 2927 to 2900'
Mud 2900 to 80' Mud Hog pumps used.
Rock 80 to 70'
Cement 70 to 55'
Mud 55 to 00'
Steel plate welded on surface pipe

(If additional description is necessary, use BACK of this sheet)

Correspondence regarding this well should be addressed to.....
Address.....

STATE OF *Kansas*, COUNTY OF *Cowley*, SS.
..... (employee of owner) or (owner or operator) of the above-described well,
being first duly sworn on oath, says: That I have knowledge of the facts, statements, and matters herein contained and the log of the above-described well as filed and that the same are true and correct. So help me God.

(Signature) *G. B. Jones*
1216 Fuller, Winfield, Kansas
(Address)

SUBSCRIBED AND SWORN to before me this *6th* day of *June*, 19 *47*
Walter C. Bailey
Notary Public.

My commission expires *June 17-1947*

Lester, SW1/4 SE1/4 SW1/4 6-34-6
Cowley Co Kansas