


Summer
Map No. **KANSAS** Sec. 6 Twp. 34 R. 2E
Well No. 1- Springgate Farm
Rees Oil Co et al Company

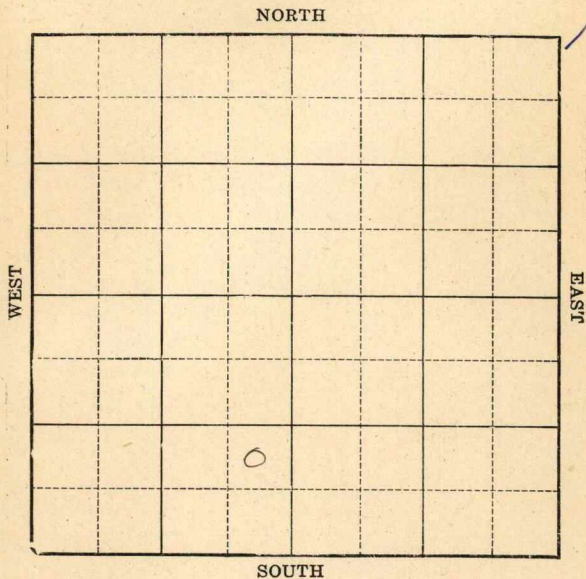

Location

Drilling Remarks

Rig Up

Drilling Remarks

RECORD

Cased in. ft.

Sand

Gas

Oil

Total Depth

PRODUCTION

1st 24 hrs. Nat.

1st 24 hrs. after shot


Gas cu. ft.

Dry Hole

Abandoned

Map No. **KANSAS** Sec. 6 Twp. 34 R. 2^EWell No. 1-Springgate FarmBrees Oil & Coal Company

NORTH

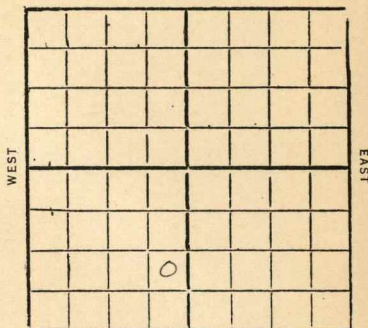 Ft. from N. Line990 Ft. from S. Line330 Ft. from E. Line1932 Ft. from W. Line

SOUTH

Date

REPORT

3/16	8" 2268 Drilg 2291
3/22	T.D. 2320' csg tools
3/30	T.D. 2385 U/R 8"
4/6	Top sand 2580 Some water 2590 S/R 8" csg
4/13	SD 2760
4/20	SD 2790
4/27	U/R 6"- 3120'
5/4	
5/11	Cand 3187-3200 HFW T.D. 3200 Set 5"- 3200 Clg out
5/18	Drilg 3538'
5/25	Top Chat 3597 HFW 3635 T.D. 3639 1/2 SD orders
6/1	—
6/8	—
6/15	—


6/22- SD 3639½' orders
 6/29 —
 7/6 —
 7/13 —
 7/20- TD 3639½'
 Fishing tools
 7/27 —
 8/3- SD 3639½'
 8/10 —
 8/17 —
 8/24 —
 8/31 —
 9/7 —
 9/14 —
 9/21 —
 9/30 —
 10/5 —
 10/12 —
 10/19 —
 10/26- TD 3639½' fsg tools
 11/2 —
 11/9 —
 11/16 —
 11/23- 5"-3658
 dreg 3662'
 11/30- 5"-3705
 SD 3710'
 12/7- 5"-3702
 dreg 3833' lime
 12/14- Base lime 3855
 SD 3865'
 12/21- Top Welcor 3955
 SD 4000' HFW

Summit
5M-8-30-PETROL

Map No. **KANSAS** Sec. 6 Twp. 34 R. 2E

Well No. 1-Spruigate Farm
Crees Oil Co et al Company

NORTH

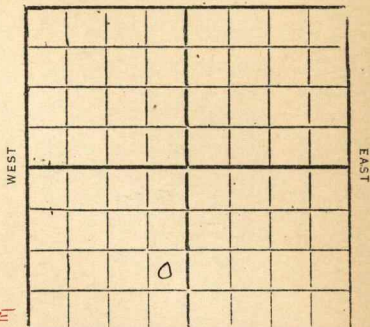

Ft. from N. Line

990 Ft. from S. Line

330 Ft. from E. Line

Ft. from W. Line

1931 ^{our lease} NE 1/4 sec. 31-33-2E
and N 1/2-SW 1/4 sec. 12-34-1E

Date

REPORT

6/24	Log
7/1	ROS
7/8	Pig
7/15	Spdg
7/22	Spud & SD
7/29	20" - 62'
8/5	Drlg 450'
8/12	15" - 895'
8/19	Drlg 1025'
8/26	SD 1435 for 10"
9/2	Drlg 1435'
9/9	12" - 1435'
9/16	Drlg 1532'
9/23	10" 1653 Clog out
9/30	Drlg 2010'
10/7	Ullie 10" - 2214'
	10" - 2220'
	Drlg 2228'
	10" - 2245'
	Drlg 2280'
	(over)

10/14- 10" collapsed 2300'
 sweating
 10/21 —
 10/28- T.D. 2300'
 fsg 10" esg
 11/4 —
 11/10 —
 11/18 —
 11/24 —
 12/2 —
 12/9 —
 12/16 —
 12/22- S.D. 2300
 10" collapsed
 12/30 —
 1932
 1/6- Dreg 2300'
 1/13- T.D. 2300' Run 10"
 1/20 —
 1/27- —
 2/3- T.D. 2300'
 dreg by 10" at 1940'
 2/10- Shut down
 2/17 —
 2/26 —
 3/2 —
 3/9- 8"-2125
 dreg 2167' (new hole)

Map No. Kansas Sec. 6 Twp 34 R. 2E


Well No. 1-Springate Farm
Trees Oil et al Company

 Ft. from N. Line

990 Ft. from S. Line

330 Ft. from E. Line

 Ft. from W. Line

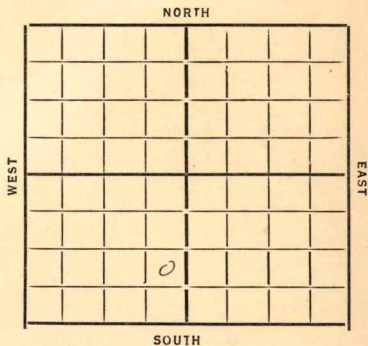

Date

REPORT

12/28 Top Wellcox 3955
TD 4000' HFW
Abandoned

*Summer*Map No. **KANSAS** Sec. *6* Twp. *34* R. *2^E*Well No. *Springgate*
Tree Oil Co et al Company

Contractor

COMPLETED**SECTION PLAT**

.....Ft. from N. Line

990 Ft. from S. Line*330* Ft. from E. Line

.....Ft. from W. Line

ABANDONED

Location.....

Rig up.....

Drilling and Remarks:

*Top Nucleon 3955**HFw 4000***RECORD**

Cased.....in.,ft.

Sand.....

Gas.....

Oil.....

Total Depth *4000***PRODUCTION**

1st 24 hrs. Nat.....

1st 24 hrs. after shot.....

Gas.....Cu. Ft.

Dry Hole. ☒Abandoned. ☒

Date

DEC 23 1932

CHAS. L. SHERWOOD

192.....

Scout

Bummer

Map No. **KANSAS** Sec. 6 Twp. 34 R. 2 ^EWell No. 1 SpringgateGreer Oil Co et al Company

Contractor

FIRST REPORTS**SECTION PLAT**

Ft. from N. Line

990 Ft. from S. Line330 Ft. from E. Line

Ft. from W. Line

Location ✓

Rig up

Drilling and Remarks:

RECORDCased in., ft.Sand Gas Oil Total Depth **PRODUCTION**1st 24 hrs. Nat. 1st 24 hrs. after shot Gas Cu. Ft.Dry Hole Abandoned

Date

JUN 24 1931

192

CHAS. L. SHERWOOD

Scout