


Section 11 Township 34S Range 7E

Well No. #1 Webb

Company O.A. Sutton

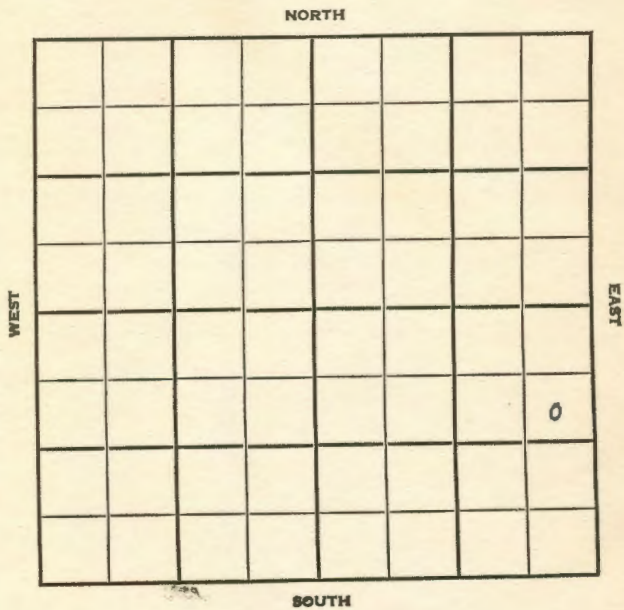

SEC. TWP. R.

11 34S 7E

WELL NO. 1 Webb FARM

COMPANY O. A. Sutton


CONTRACTOR Sunflower Drlg. Tools Wildcat

990 Ft. from N. Line

Ft. from S. Line

330 Ft. from E. Line

Ft. from W. Line

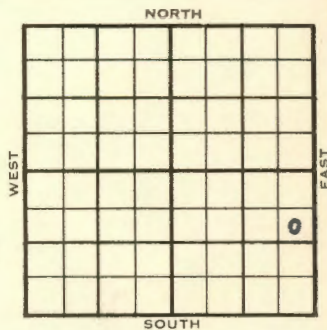

SE NE SE
CRA DHM

	ELEVATION	REPORT
1954	---	
12/8		Spud 12-3-54 8" @ 103' w/75 sks Lay 1958', Lay sd 2004', Base Lay 2076 Low Lay 2147' Drlg. 2200'
12/15		Spud 12-3-54 D & A TD 2045 8" @ 103' Layton 1958 B. Layton 2076 KC 2365 Cleve 2409 Oswego 2458 Miss 2783 DST 2805-11 open 1 hr rec 5' mud TD 2845 D & A
		ABANDONED

1954

ELEVATION

REPORT

12/8

Spud 12-3-54
8" @ 103' w/75 sks
Lay 1958', Lay sd 2004', Base Lay 2076
Low Lay 2147'
Drlg. 2200'

12/15

Spud 12-3-54 D & A TD 2045
8" @ 103' Layton 1958 B. Layton
2076 KC 2365 Cleve 2409
Oswego 2458 Miss 2783
DST 2805-11 open 1 hr rec 5' mud
TD 2845 D & A

ABANDONED

