


Section 25 Township 34 Range 7E

Well No. 1 Wilson

Company Orville Parker

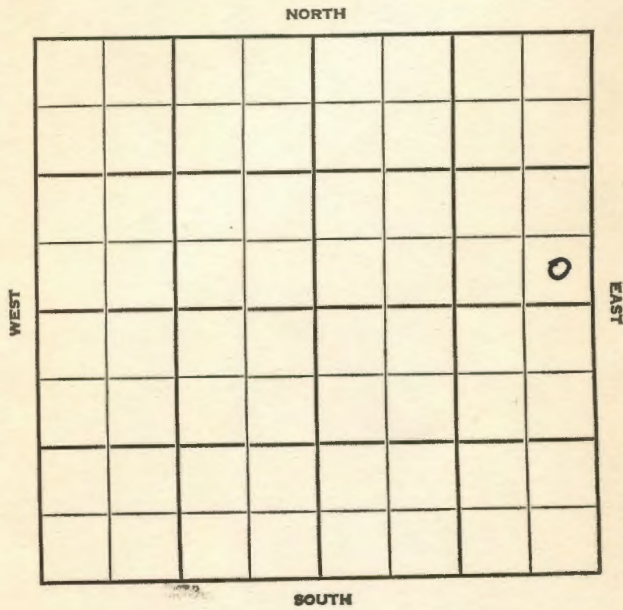

WOWBY BANDAD

SEC. <u>25</u>	TWP. <u>34</u>	R. <u>7E</u> ✓
WELL NO. <u>1 Wilson</u> FARM		
COMPANY <u>Orville Parker</u>		
CONTRACTOR <u>Musgrove Wildcat</u>		

_____ Ft. from N. Line	WEST	NORTH	EAST
<u>330</u> _____ Ft. from S. Line			
<u>330</u> _____ Ft. from E. Line			
_____ Ft. from W. Line			
SE SE NE		SOUTH	

	ELEVATION	REPORT
1954	1221	
7/28	Spdg 7-21-54 8" @ 125 Drlg. 1400	
8-11	Spdg 7-21-54 D&A TD 2810 8" @ 125 DST 2465-2505 open 1 hr. Rec. 32' mud 55# Bart. 2630 Miss. 2750 DST 2747-52 open 1/2 hr. Rec. 9' mud TD 2810 D&A	
ABANDONED		

County **Cowley** State **Kansas**
 Sec. **25** (Blk. Twp.) **34** (Sur. Rge.) **7E** Map No.
 Operator **Orville Parker**
 Well No. **1** Farm **Wilson**
 Elev. **1221** Location **SE SE NE**

330 Ft. From **S** Line **NE**
330 Ft. From **E** Line **Quarter**
 Ist. Report
 Completion **AUG 11 1954**
 Remarks **Wildcat**
Musgrove - Contr.
 Spudding Date **7-21-54**

Drlg. Data **D & A TD 2810**
8" @ 125 DST 2465-2505 open 1 hr.
Rec. 32' mud 55# Bart. 2630
Miss. 2750 DST 2747-52 open 1/2 hr.
Rec. 9' mud TD 2810
D & A

72

County **Cowley** State **Kansas**
 Sec. **25** (Blk. Twp.) **34** (Sur. Rge.) **7E** Map No.
 Operator **Orville Parker**
 Well No. **1** Farm **Wilson**
 Elev. Location **SE SE NE**

330 Ft. From **S** Line **NE**
330 Ft. From **E** Line **Quarter**
 Ist. Report **JUL 28 1954**
 Completion
 Remarks
Musgrove - Contr.
 Spudding Date **7-21-54**

Drlg. Data **Wildcat**
8" @ 125 drlg. 1400

J. G. MCGHEE