


Cowley

KANSAS

SECTION 1 TOWNSHIP 34 RANGE 7E

WELL NO. #1 Jarvis

COMPANY McNeish & Gralapp

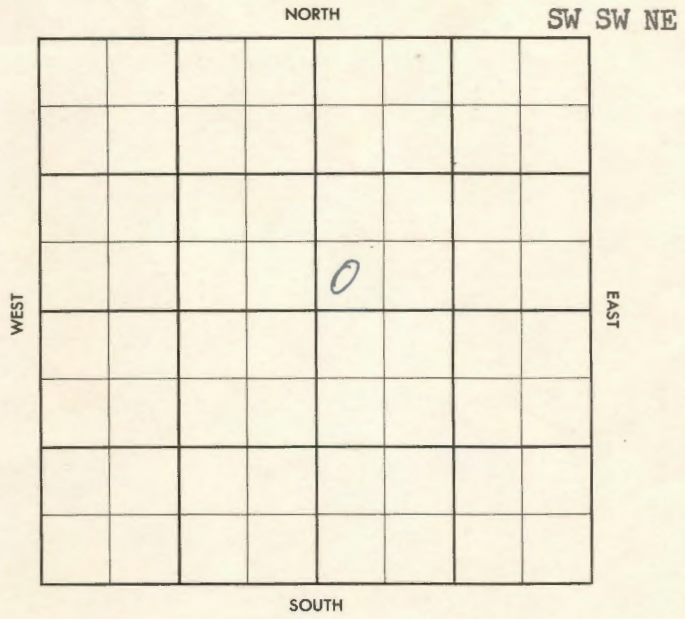

County Cowley Elev. 1252 KB  
 Sec. 1 Twp. 34 Rge. 7E  
 Company McNeish & Gralapp  
 FarmName Jarvis No. 1

TOPS	DEPTH	LOG	DATUM	Loc. in Sec.
Anh.				SW SW NE
Tp.				
H.				
Tr.				
Dg.				
Bl.				
L. ayton sd	1905	1905		Geol.
K.C.		2190		Contr.
B.K.C.				
Ce.				
C.		2776		Pool
M.				
M.				
K.				
Mz.				
Me.				
V.				
S.				
S.				
A		3192		
R.				
Pe.				
G.				
T.D.	3222			

ABANDONED  
 o  
 AUG 14 '57

Date Comm. 7-30-57 Skelly (FO) & (DHM)  
 8" @ 202, Drlg. 2565 X Log Tops  
 Lay 1905 KC 2190 MISS 2776  
 Arb 3192 RTD 3222 no  
 shows no 1st DEQ  
 119 7-30-57

County Cowley Elev. 1252 KB  
 Sec. 1 Twp. 34 Rge. 7E  
 Company McNeish & Gralapp  
 FarmName Jarvis No. 1

TOPS	DEPTH	LOG	DATUM	Loc. in Sec.
Anh.				SW SW NE
Tp.				
H.				
Tr.				
Dg.				
Bl.				
L. ayton sd	1905			Geol.
K.C.				Contr.
B.K.C.				
Ce.				
C.				
M.				Pool
M.				
K.				
Mz.				
Me.				
V.				
S.				
S.				
A				
R.				
Pe.				
G.				
T.D.				

FIRST REPROB  
 o  
 AUG 7 '57

Date Comm. 7-30-57 Skelly (FO) & (DHM)  
 8" @ 202, Drlg. 2565

~~30~~