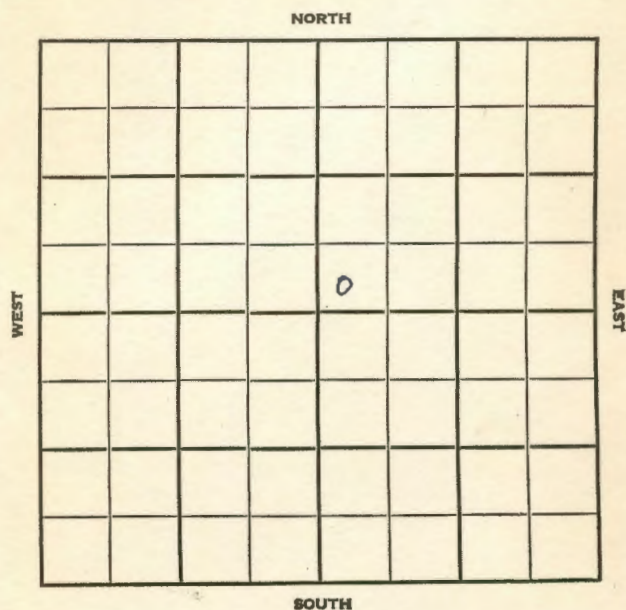


Cowley

KANSAS

Section 29 Township 34 Range 7 EWell No. #1 MosierCompany C. A. Black

SEC.

29

TWP.

34

R.

7E

WELL NO.

#1 Mosier

FARM

COMPANY

C. A. Black

CONTRACTOR

Wakefield


Wildcat

_____ Ft. from N. Line

_____ Ft. from S. Line

_____ Ft. from E. Line

_____ Ft. from W. Line

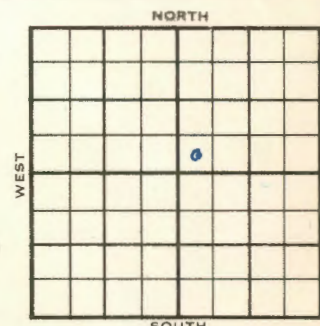

SW SW NE

1955

ELEVATION

REPORT

8/17 Location

8/31 Comm 8-22-55
 H Layton 2126
 BKC 2554
 Ce Cleve 2569
 C Oswego 2613
 M Chert 2971
 M Lm 2987
 TD 3002
 8 5/8" @ 100
 D & A

ABANDONED

County Cowley Elev. _____
 Sec. 29 Twp. 34 Rge. 7E
 Company C. A. Black
 Farm Name Mosier No. 1

TOPS	DEPTH	LOG	DATUM	Loc. in Sec.
Anh.				SW SW NE
TP.				
H. <u>Layton</u>	<u>2126</u>		<u>163</u>	
Tr.				
Dg.				
BL.				
L.				
K.C.				Geol.
B.K.C.	<u>2554</u>		<u>1291</u>	Contr.
Ce. <u>Clave</u>	<u>2569</u>		<u>1306</u>	
C. <u>Cowley</u>	<u>2613</u>		<u>1360</u>	<u>Wakefield</u>
M. <u>Clave</u>	<u>2971</u>		<u>1708</u>	
M. <u>km</u>	<u>2987</u>		<u>1724</u>	Pool
K.				Wildcat
Mz.				
Mo.				
V.				
S.				
S.				
A.				
R.				
PE.				
G.				
TD.	<u>3002</u>			

Date Comm. 8-22-558 5/8" @ 100

D & A

AUG 31 1955

County Cowley Elev. _____
 Sec. 29 Twp. 34 Rge. 7E
 Company C. A. Black
 Farm Name Mosier No. 1

TOPS	DEPTH	LOG	DATUM	Loc. in Sec.
Anh.				SW SW NE
TP.				
H.				
Tr.				
Dg.				
BL.				
L.				Geol.
K.C.				Contr.
B.K.C.				
Ce.				<u>Wakefield</u>
C.				
M.				Pool
M.				
K.				<u>Wildcat</u>
Mz.				
Mo.				
V.				
S.				
S.				
A.				
R.				
PE.				
G.				
TD.				

Date Comm.

Location

AUG 17 55
 0
 FIRST REPORT