


Map No. Kans Sec. 31 Twp. 34 R. 7
 Well No. 1 - Gearhart Farm
O. H. Lewis Company

NORTH

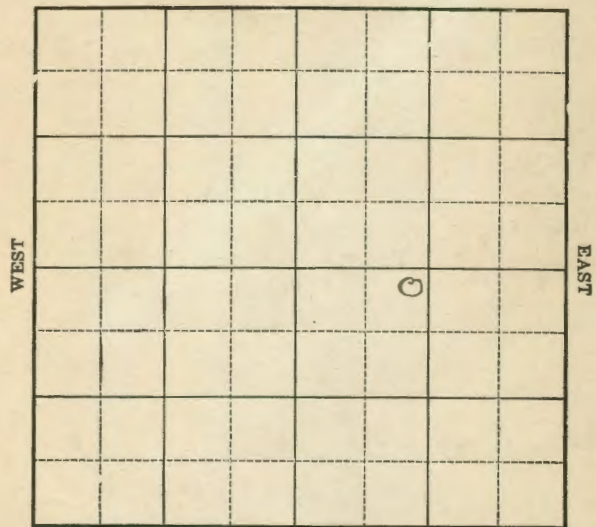

SOUTH

Location _____
 Drilling Remarks _____

Rig Up 1296
 Drilling Remarks _____

RECORD

Cased _____ in. _____ ft.
 Sand _____
 Gas _____
 Oil _____
 Total Depth _____

PRODUCTION

1st 24 hrs. Nat. _____
 1st 24 hrs. after shot _____
 Gas _____ cu. ft.
 Dry Hole _____
 Abandoned _____


Map No. Kans Sec. 31 Twp. 34 R. 7
 Well No. 1 - Gearhart Farm
O. H. Lewis Company

NORTH

250 Ft. from N. Line

_____ Ft. from S. Line

_____ Ft. from E. Line

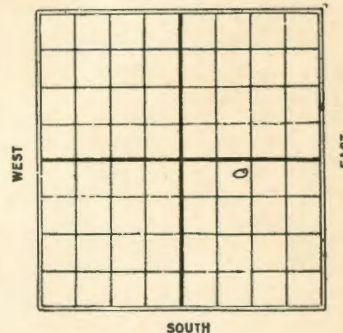1020 Ft. from W. Line

SOUTH

1926

Date

REPORT

10/20 location
10/27 Abandoned location

Cowley
 3 KANSAS
 Map No. 31 Sec. 34 Twp. 34 R. 7
 Well No. 1 *Beckhart*
O.H. Lewis Company

Contractor

FIRST REPORTS

SECTION PLAT

750 Ft. from N. Line
 _____ Ft. from S. Line
 _____ Ft. from E. Line
1020 Ft. from W. Line

		0	

Location ☒

Rig up _____

Drilling and Remarks:

RECORD

Cased _____ in., _____ ft.
 Sand _____
 Gas _____
 Oil _____
 Total Depth _____

PRODUCTION

1st 24 hrs. Nat. _____
 1st 24 hrs. after shot _____
 Gas _____ Cu. Ft.
 Dry Hole _____
 Abandoned _____

Date

OCT 20 1926

CHAS. L. SHERWOOD

192

Scout

Cowley
 3 KANSAS
 Map No. 31 Sec. 34 Twp. 34 R. 7
 Well No. 1 *Beckhart*
O.H. Lewis Company

Contractor

COMPLETED

SECTION PLAT

750 Ft. from N. Line
 _____ Ft. from S. Line
 _____ Ft. from E. Line
1020 Ft. from W. Line

		0	

ABANDONED

Location _____

Rig up _____

Drilling and Remarks:

RECORD

Cased _____ in., _____ ft.
 Sand _____
 Gas _____
 Oil _____
 Total Depth _____

PRODUCTION

1st 24 hrs. Nat. _____
 1st 24 hrs. after shot _____
 Gas _____ Cu. Ft.
 Dry Hole *Location*
 Abandoned _____

Date

OCT 27 1926

CHAS. L. SHERWOOD

192

Scout