


Cowley
 KANSAS
 Map No. _____ Sec. 31 Twp. 34 R. 7

Well No. 1 - Gearhart Farm _____

~~Joe. Nathan Stab~~ Company
Pryor & Lockhart

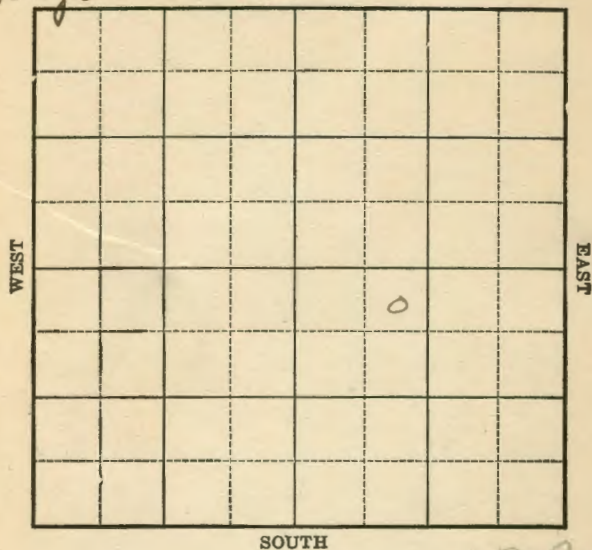

Location _____ Rig Up _____
 Drilling Remarks _____ Drilling Remarks _____

RECORD		PRODUCTION	
Cased _____ in.	_____ ft.	1st 24 hrs. Nat.	_____
Sand _____		1st 24 hrs. after shot	_____
Gas _____		Gas _____ cu. ft.	
Oil _____		Dry Hole _____	
Total Depth _____		Abandoned _____	

Kansas
 Map No. _____ Sec. 31 Twp. 34 R. 7

Well No. 1 - Gearhart Farm _____

~~Joe. Nathan Stab~~ Company
Pryor & Lockhart


330 Ft. from N. Line

_____ Ft. from S. Line

_____ Ft. from E. Line

990 Ft. from W. Line

1927

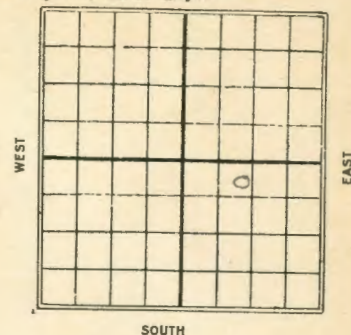

Date	REPORT
3/1	Location
3/9	_____
3/16	_____
3/24	_____
3/30	_____
4/7	_____
4/13	_____
4/20	_____
4/27	_____
5/5	_____
5/12	_____
5/18	_____
5/25	_____
6/1	_____
6/7	_____
6/15	_____
6/22	Moving in timbers
6/29	Timbers
7/7	_____
7/13	_____
7/20	_____
7/28	_____

8/4 - Timbers

8/10 - Rigging up.

8/18

8/24 - Spudding

9/1 - Drlg 650.

9/7 - Setting 12"-1150

9/14 - Drlg 1400

9/19 - fishing 1750

10/6

10/12

10/19 - Drlg 2200.

10/27 - set 8"-2075-S.D.

11/2 -

11/9

11/16

11/23

11/30 - Getting ready to start up

12/7 - H.F.W. 2250

Drlg 2547

12/14 - Drlg 2880'

12/1 - Chat 3023-29 - u.R. 6"-

12/19 - Drilling 3100-
T.D. 3030-

1928

1/5 - Chat 3023-29 - u.R. -
T.D. 3100-

1/11 - Drlg 3250'

1/18 - Chat 3023-3029

Base lime 3380

Shale 3380-3440

Sile. lime 3440-64 H.F.W.

S. & A. 3464

Form

3-23-11959.

Cowley

3 **KANSAS** 31 34 7
 Map No. Sec. Twp. R.
 Well No. 1 *Seaphart*
Joe Nathan et al Company
 Contractor

FIRST REPORTS

SECTION PLAT

330. Ft. from N. Line
 Ft. from S. Line
 Ft. from E. Line
 990 Ft. from W. Line

		0	

Location ☒
 Rig up
 Drilling and Remarks:

RECORD
 Cased _____ in., _____ ft.
 Sand _____
 Gas _____
 Oil _____
 Total Depth _____

PRODUCTION
 1st 24 hrs. Nat. _____
 1st 24 hrs. after shot _____
 Gas _____ Cu. Ft.
 Dry Hole _____
 Abandoned _____

Date

MAR 2 1927

CHAS. L. SHERWOOD

192

Scout

Form 26-1M Bks. 3-23-11959.

Cowley

3 **KANSAS** 31 34 7
 Map No. Sec. Twp. R.
 Well No. 1 *Seaphart*
Pryor & Houshart Company
 Contractor

COMPLETED

SECTION PLAT

330 Ft. from N. Line
 Ft. from S. Line
 Ft. from E. Line
 990 Ft. from W. Line

		0	

ABANDONED

Location
 Rig up
 Drilling and Remarks:

Chat 3023-29'
Base line 3380'
shole 3380-3440
slc line 3440-64
14 PW

RECORD
 Cased _____ in., _____ ft.
 Sand _____
 Gas _____
 Oil _____
 Total Depth *3464*

PRODUCTION
 1st 24 hrs. Nat. _____
 1st 24 hrs. after shot _____
 Gas _____ Cu. Ft.
 Dry Hole ☒
 Abandoned ☒

Date

JAN 18 1928

CHAS. L. SHERWOOD

192

Scout

3 **KANSAS** 31 Twp. 34 R. 7 E

Well No. 1 *Searchant*

Pryor & Lockhart Company

Contractor

CORRECTION

330 Ft. from N. Line

Ft. from S. Line

Ft. from E. Line

990 Ft. from W. Line

SECTION PLAT

		o	

Location ✓

Rig up

Drilling and Remarks:

*Chg ownership
to above*

RECORD

Cased _____ in., _____ ft.

Sand _____

Gas _____

Oil _____

Total Depth _____

PRODUCTION

1st 24 hrs. Nat. _____

1st 24 hrs. after shot _____

Gas _____ Cu. Ft.

Dry Hole _____

Abandoned _____

Date

MAR 9 1927 CHAS. L. SHERWOOD

192 Scout