


KANSAS

Section 36 Township 34 Range 7E

Well No. #1 Asbury

Company Musgrove Pet.

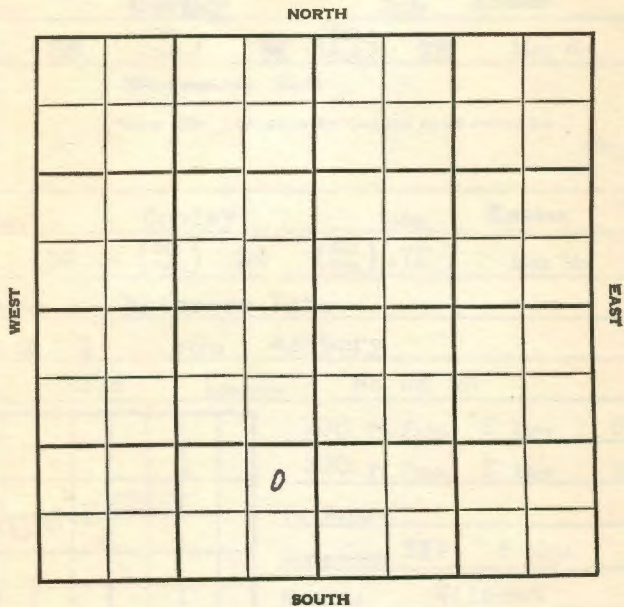


SOUTH

SEC. 36	TWP. 34	R. 7E
---------	---------	-------

WELL NO. 1 Asbury FARM

COMPANY Musgrove Pet.

CONTRACTOR Musgrove Wildcat

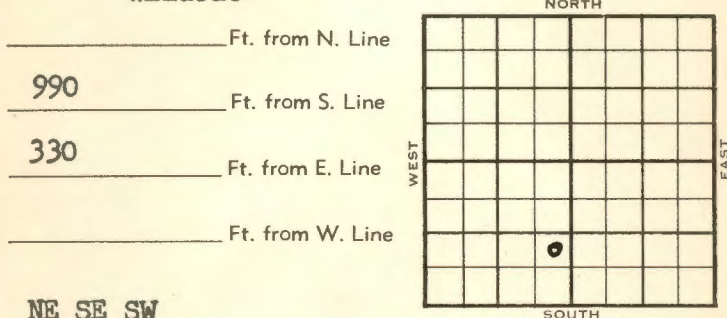



Ft. from E. Line

Ft. from W. Line

NE SE SW

1954	ELEVATION 1215'	REPORT
------	-----------------	--------

8/11 Spdg 8-4-54  
8" @ 103  
Drlg 1575

9/8 Spud 8-4-54 - Abd.  
TD 2797'  
8" @ 103'  
Stal. 1648', Layton 1820', KC 2314'  
DST 2397-2410', opn 1 hr., rec. 60' gas, 35' socm, 170#  
Burg. 2733', Miss 2737'  
DST 2733-50', opn 1 hr., rec. 800' gas, 37' hocm, 170#  
TD 2797'  
5" @ 2796'  
CO to 2780'  
42/2765-72, 72/2740-52, 12/2734-36,  
5/9 go 13 hrs., SP 2707 frac  
sd-frac, S/30 bop S/1/2 boph, 90/2397-2412, S/4 gfph 4 hrs., 3000A S/10 bfph  
Temp. abd.

ABANDONED

