
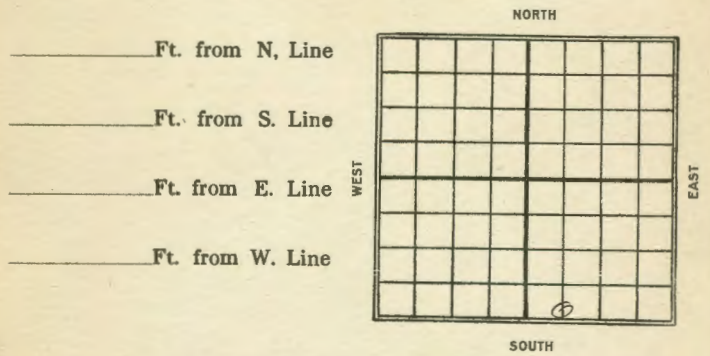


Map No. _____ Sec. 17 Twp. 34 R. 8
Well No. #1 Burkett Farm _____
West et al Company _____

Map No. _____ Sec. 17 Twp. 34 R. 8
Well No. #1 Burkett Farm _____
West et al Company _____

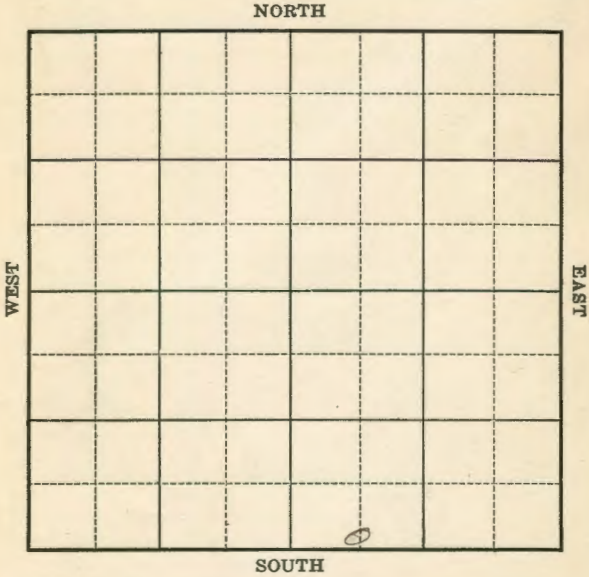

_____ Ft. from N. Line
_____ Ft. from S. Line
_____ Ft. from E. Line
_____ Ft. from W. Line

Date 1922
5/21

REPORT

DQA 2687
21822293 du Shot 100gts
21822505

Location _____

Rig Up _____

Drilling Remarks:

Drilling Remarks:

RECORD

PRODUCTION

Cased _____ in. _____ ft.

1st 24 hrs. Nat. _____

Sand _____

1st 24 hrs. after shot _____

Gas _____

Gas _____ cu. ft.

Oil _____

Dry Hole _____

Total Depth _____

Abandoned _____

Map No. 28 Kansas Sec. 17 Twp. 34 R. 8

Well No. 1 - Burnett
West, et al. Company

Contractor

FIRST REPORT

SECTION PLAT

----- Ft. from N. Line
----- Ft. from S. Line
----- Ft. from E. Line
----- Ft. from W. Line

ABANDONED

Location -----
Rig up -----
Drilling and Remarks:

1040
2687
sand (22,29,10)
2250'
shot 100ft

RECORD

Cased ----- in., ----- ft.
Sand -----
Gas -----
Oil -----
Total Depth -----

PRODUCTION

1st 24 hrs. Nat. -----
1st 24 hrs. after shot -----
Gas ----- Cu. Ft.
Dry Hole -----
Abandoned -----

Date

5/21 191. McBee Scout