


Section 17 Township 34 Range 8 E

Well No. # 1 Briscoe

Company Gaylord Swan

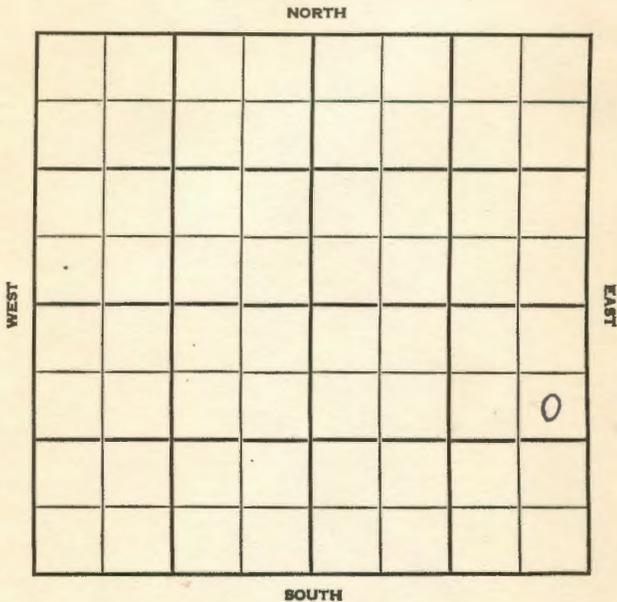

SEC.	TWP.	R.
17	34	8 E

WELL NO. # 1 Briscoe FARM

COMPANY Gaylord Swan

CONTRACTOR Kirkpatrick Wildcat


990 Ft. from N. Line

Ft. from S. Line

330 Ft. from E. Line

Ft. from W. Line

SE NE SE

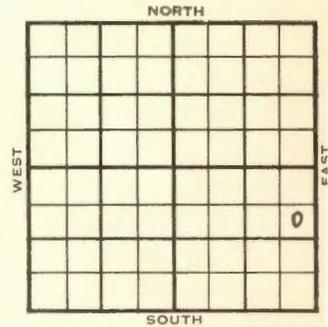

1954	ELEVATION	REPORT
	1280'	

12/15 Spud 12-8-54
 8" @ 105 Layton 1797 KC 2135
 eru 2281 Oswego 2357'
 DST 2363-83 open 2 hr rec 50' mud & SW. 525# Drlg.

12/22 Spud 12-8-54 D & A TD 2767
 8" @ 105 Layton 1797' KC 2135'
 eru 2281 Oswego 2357'
 DST 2363-83 open 2 hr rec 50' mud & SW. 525# Miss 2712
 TD 2767' D & A

ABANDONED

