

8-1065/DNL

Section 5 Township 34 Range 1E

Well No. 1 Johnson

Company McGuire, Inc. (Harry Mack)

NORTH

							0

WEST

EAST

SOUTH

Sumner

KANSAS

SEC.	58- ^{Kos} D ^W	TWP.	34	R.	1 E ✓
------	-----------------------------------	------	----	----	-------

WELL NO. # 1 Johnson FARM

COMPANY

CONTRACTOR McGuire Inc. (Harry Mack)


Horndon Drlg.
Wildcat

330 Ft. from N. Line

Ft. from S. Line

330 Ft. from E. Line

Ft. from W. Line

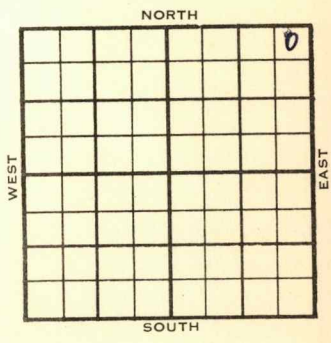

NE NE NE

ELEVATION	REPORT
1954	-----
3/31	Spud 3-28-54 8" @ 362 WOC
4/7	Spud 3-28-54 D & A TD 3200' 8" @ 362 Stal. 2742 Layton 3175 DST 3180-3200, open 1/2 hr rec 540' SW 1200# TD 3200 D & A
	ABANDONED

County 1665 Sumner State Kansas

Sec. 8 ^{D&A} 5 (Blk. Twp.) 34 (Sur. Rge.) 1E Map No.

Operator McGuire Inc. (Harry Mack)

Well No. 1 Farm Johnson

Elev. _____ Location NE NE NE



330 Ft. From N Line NE

330 Ft. From E Line Quarter

Ist. Report _____

Completion APR 7 1954

Remarks Wildcat

Herndon Drlg. - Contr.

Spudding Date 3-28-54

Drlg. Data D & A TD 3200

8" @ 362 Stal. 2742 Layton 3175

DST 3180-3200 open 1/2 hr. Rec. 540' sw

1200# TD 3200

D & A

J. G. McGEHEE

8-1068/DRL

County Sumner State Kansas

Sec. 5 (Blk. 34 (Sur. 1E (Twp. Map No.)

Operator McGuire Inc. (Harry Mack)

Well No. 1 Farm Johnson

Elev. _____ Location NE NE NE

330 Ft. From N Line NE

330 Ft. From E Line Quarter

Ist. Report MAR 31 1954

Completion _____

Remarks _____

Herndon Drlg. - Contr.

Spudding Date 3-28-54

Drlg. Data Wildcat

8" @ 362 WOC