


Chautauqua

Map No. \_\_\_\_\_ Sec. 16 Twp. 34 R. 9<sup>E</sup>Well No. 1 Layton Farm \_\_\_\_\_York State Company \_\_\_\_\_

NORTH

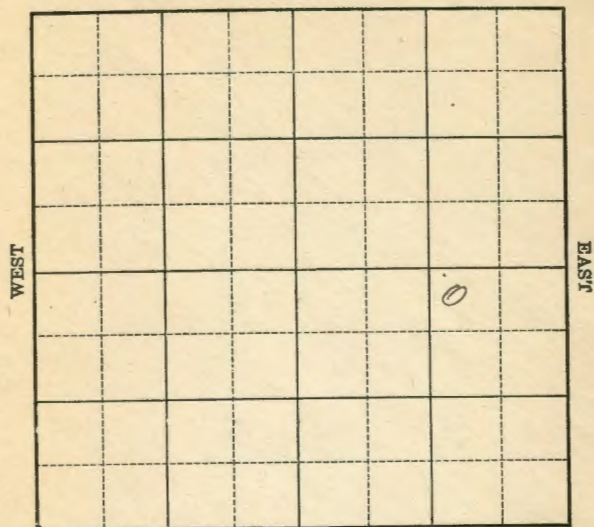

SOUTH

Location \_\_\_\_\_  
Drilling Remarks \_\_\_\_\_Rig Up \_\_\_\_\_  
Drilling Remarks \_\_\_\_\_

## RECORD

Cased \_\_\_\_\_ in. \_\_\_\_\_ ft.  
 Sand \_\_\_\_\_  
 Gas \_\_\_\_\_  
 Oil \_\_\_\_\_  
 Total Depth \_\_\_\_\_

## PRODUCTION

1st 24 hrs. Nat. \_\_\_\_\_  
 1st 24 hrs. after shot \_\_\_\_\_  
 Gas \_\_\_\_\_ cu. ft. \_\_\_\_\_  
 Dry Hole \_\_\_\_\_  
 Abandoned \_\_\_\_\_

Chautauqua

Map No. \_\_\_\_\_ Sec. 16 Twp. 34 R. 9<sup>E</sup>Well No. 1 Layton Farm \_\_\_\_\_York State Company \_\_\_\_\_


NORTH

556' Ft. from N. Line

\_\_\_\_\_ Ft. from S. Line

1070' Ft. from E. Line

\_\_\_\_\_ Ft. from W. Line

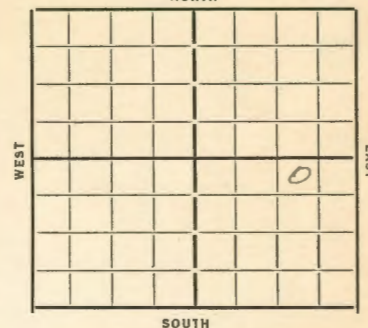

SOUTH

Date 1933

## REPORT

12/6 1019 500'12/12 " 119012/22 " 125019341/10 Quadrangle 1977 T.D. 1985 hdy**ABANDONED**

Chautauqua

Map No. 3 Sec. 16 Twp. 34 R. 9E

Well No. 1-Layton

York State Company

Contractor

## FIRST REPORTS

250 Ft. from N. Line

Ft. from S. Line

1070 Ft. from E. Line

Ft. from W. Line

## SECTION PLAT

|  |  |  |   |
|--|--|--|---|
|  |  |  |   |
|  |  |  |   |
|  |  |  | 0 |
|  |  |  |   |

Location

Rig up

Drilling and Remarks:

Deq 500

## RECORD

Cased in, ft.

Sand

Gas

Oil

Total Depth

## PRODUCTION

1st 24 hrs. Nat.

1st 24 hrs. after shot

Gas Cu. Ft.

Dry Hole

Abandoned

Date

12-6-33 192 C. Mannick Scout

Chautauqua

Map No. 3 Sec. 16 Twp. 34 R. 9E

Well No. 1-Layton

York State Company

Contractor

## SECTION PLAT

250 Ft. from N. Line

Ft. from S. Line

1070 Ft. from E. Line

Ft. from W. Line

|  |  |  |   |
|--|--|--|---|
|  |  |  |   |
|  |  |  |   |
|  |  |  | 0 |
|  |  |  |   |

Location

Rig up

Drilling and Remarks:

10 + H

ABANDONED

## RECORD

Cased in, ft.

Sand 1977

Gas

Oil

Total Depth 1985

## PRODUCTION

1st 24 hrs. Nat.

1st 24 hrs. after shot

Gas Cu. Ft.

Dry Hole

Abandoned

Date

1-10-34 192 C. Mannick Scout