


Chaut


KANSAS

Section 20 Township 34 Range 9-E
 Well No. 4 - Borroum
 Company Sinclair Prairie

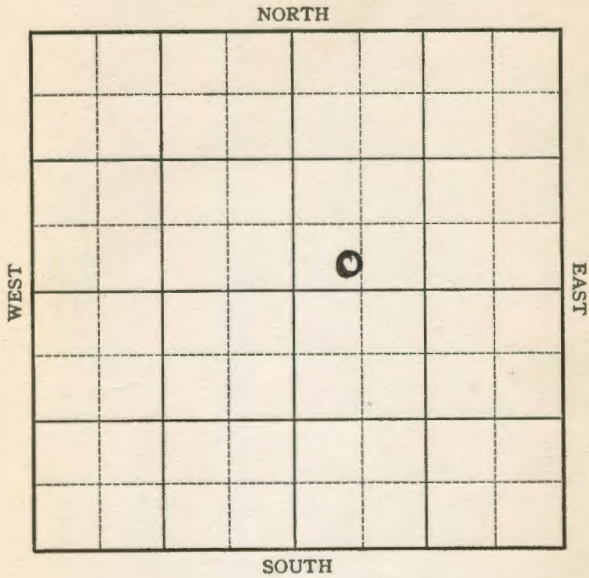

Sec. 20 Twp. 34 R. 9-E
 Well No. #4 Borroum Farm _____
 Company Sinclair-Prairie

_____ Ft. from N. Line
220 Ft. from S. Line
 _____ Ft. from E. Line
600 Ft. from W. Line

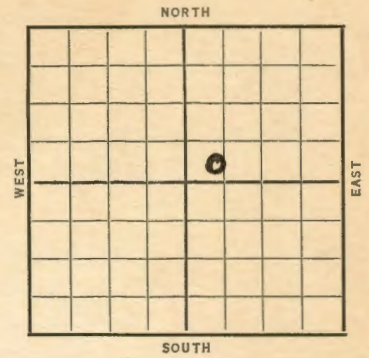

Date	REPORT
1937	
6/9	Machine.
6/19	Drlg. 170'.
6/25	10" @ 712'. Drlg. 750'.
7/2	" " " "
7/9	" " " "
7/16	TD 1792' Acidizing.
7/23	1000 acid. Pumped 41 bbls. 6 hrs.
7/28	6" @ 1632' Pawnee 1777' TD 1792' 1000 acid Pot 100
	COMPLETED

Map No. 3 Sec. 20 Twp. 34 R. 9E

Well No. 4 - Borroum

Sinclair Prairie Company

Contractor

COMPLETED

SECTION PLAT

_____ Ft. from N. Line

220 Ft. from S. Line

_____ Ft. from E. Line

600 Ft. from W. Line

		0	

Location _____

Rig up _____

Drilling and Remarks:

1000 Acid

Pat - 100

RECORD

Cased 6 in., 1632 ft.

Sand Pawnee 1777

Gas _____

Oil _____

Total Depth 1792

PRODUCTION

1st 24 hrs. Nat. _____

1st 24 hrs. after shot _____

Gas _____ Cu. Ft.

Dry Hole _____

Abandoned _____

Date

JUL 28 1937 19

H. D. Hatfield Scout

Map No. 3 Sec. 20 Twp. 34 R. 9E

Well No. 4 - Borroum

Sinclair Prairie Company

Contractor

FIRST REPORT

SECTION PLAT

_____ Ft. from N. Line

220 Ft. from S. Line

_____ Ft. from E. Line

600 Ft. from W. Line

		0	

Location _____

Rig up _____

Drilling and Remarks:

Machine

RECORD

Cased _____ in., _____ ft.

Sand _____

Gas _____

Oil _____

Total Depth _____

PRODUCTION

1st 24 hrs. Nat. _____

1st 24 hrs. after shot _____

Gas _____ Cu. Ft.

Dry Hole _____

Abandoned _____

Date

JUN 9 1937 19

H. D. Hatfield Scout