


KANSAS

Chaut

Section 20 Township 34 Range 9-E
 Well No. 5 - Borrum (Borroum)
 Company Sinclair-Prairie


NORTH

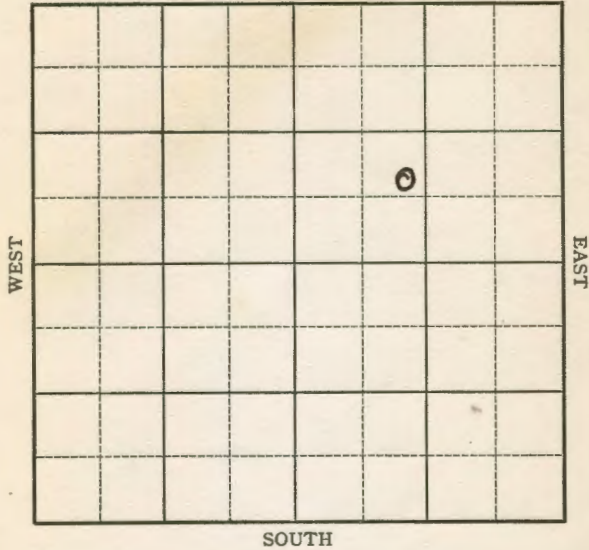

Sec. 20 Twp. 34 R. 9-E
 Well No. #5 Borrum Farm
Sinclair-Prairie Company

NORTH

 Ft. from N. Line
720 Ft. from S. Line
 Ft. from E. Line
1100 Ft. from W. Line

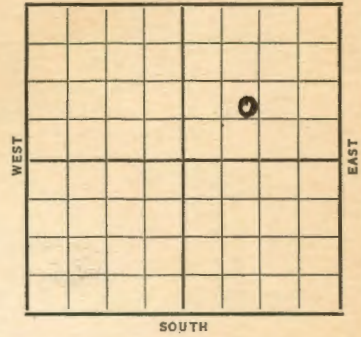

Date

REPORT

1937

8/18

Location

8/28

"

9/1

Abandoned Location

ABANDONED

Chaut, KANSAS

Map No. 3 Sec. 20 Twp. 34 R. 9E

Well No. 5-Borrum

Sinclair Prairie Company

Contractor

ABANDONED

SECTION PLAT

		0	

Ft. from N. Line

720 Ft. from S. Line

Ft. from E. Line

1100 Ft. from W. Line

Location

RECORD

Cased in., ft.

Sand

Gas

Oil

Total Depth

PRODUCTION

1st 24 hrs. Nat.

1st 24 hrs. after shot

Gas Cu. Ft.

Dry Hole

Abandoned

Date

SEP 1 1937 19

H. D. Hatfield Scout

Chaut, KANSAS

Map No. 3 Sec. 20 Twp. 34 R. 9E

Well No. 5-Borrum

Sinclair Prairie Company

Contractor

FIRST REPORT

SECTION PLAT

		0	

Ft. from N. Line

720 Ft. from S. Line

Ft. from E. Line

1100 Ft. from W. Line

Location

RECORD

Cased in., ft.

Sand

Gas

Oil

Total Depth

PRODUCTION

1st 24 hrs. Nat.

1st 24 hrs. after shot

Gas Cu. Ft.

Dry Hole

Abandoned

Date

AUG 18 1937 19

H. D. Hatfield Scout