

Sumner


KANSAS

SEC.	TWP.	R.
9	34	1E

WELL NO. _____
 1 Hunt "A" FARM
 COMPANY

CONTRACTOR
 Herndon Drlg.
 Herndon Drlg.

_____ Ft. from N. Line
 330 _____ Ft. from S. Line
 _____ Ft. from E. Line
 1320 _____ Ft. from W. Line
 C S/2 S/2 SW

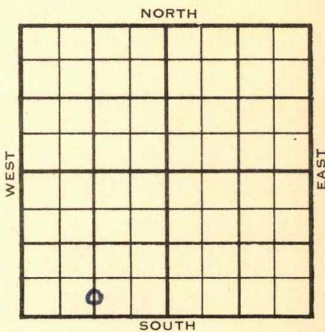

1953	ELEVATION	REPORT
	1185'	

9/23 MIM
 11/4 Spud 9-22-53
 Oil Well
 TD 3061'
 8" @ 365
 Layton 3036'
 DST 3036-60, opn 3/4 hrs., rec.
 190' oil, 10' mud, 10' mud, 1105#
 TD 3061'
 5" @ 3037'
 CO to 3061'
 S/4 boph 15 hrs.
 Comp. 100 bopd

COMPLETED

County Sumner State Kansas

Sec. 9 (Blk. 34 (Sur. 1E (Twp. Map No.

Operator Herndon Drlg.

Well No. 1 Farm Hunt "A"

Elev. 1185 Location C S $\frac{1}{2}$ S $\frac{1}{2}$ SW

COMPLETE

330 Ft. From S Line SW

1320 Ft. From W Line Quarter

Ist. Report

Completion NOV 4 1953

Remarks

Herndon Drlg. - Contr.

Spudding Date 9-22-53

Drlg. Data Oil well TD 3061

8" @ 365 Layton 3036 DST 3036-60

open 3/4 hr. Rec. 190' oil 10' mud

10' wtr. 1105# TD 3061 5" @ 3037

CO to 3061 S/ 4 boph 15 hr.

Comp. 100 bopd

