

Sumner

KANSAS


SEC. 9	TWP. 34	R. 1E
-----------	------------	----------

WELL NO. #2 Hunt "A" FARM

COMPANY Herndon Drlg.

CONTRACTOR Herndon Drlg.

_____ Ft. from N. Line
 990 _____ Ft. from S. Line
 530 _____ Ft. from E. Line
 _____ Ft. from W. Line

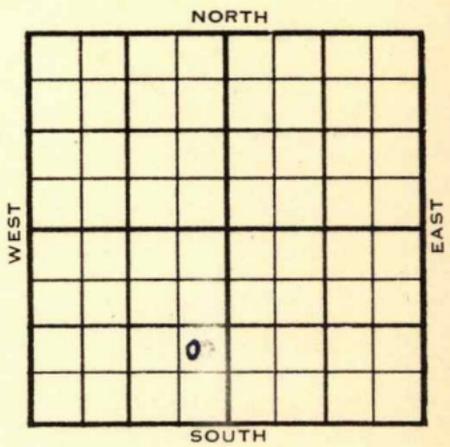

NE SE SW

	ELEVATION	REPORT
1953	1190'	
11/11		Setting Surface.
12/2		Spud 11-9-53 D & A TD 3728 8" @ 358 Layton 3048' Miss 3692 TD 3728 D & A

ABANDONED

