

Map No. **KANSAS** Sec. 9 Twp. 34 R. 1E

Well No. 1- Welch Farm


Laredo Oil Company
Harris & Haun

 Ft. from N. Line

300 Ft. from S. Line

 Ft. from E. Line

300 Ft. from W. Line

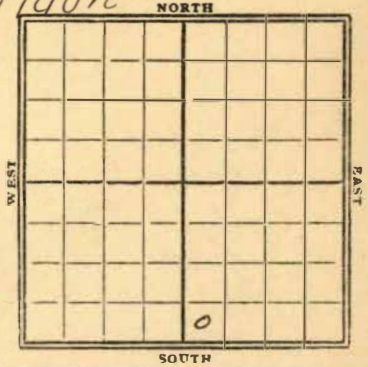

1929

Date	REPORT
5/29	Location
6/15	Spdy 50'
6/12	Drly 350'
6/19	" 560'
6/26	Fsy 800'
7/2	TD 800'
	Spinning rig
7/10	Spdy 200' (new hole)
7/17	Drly 400'
7/24	" 1065'
7/31	" 1500'
8/7	set 10"-1975'
8/14	Drly 2120'
8/21	" 2300'
8/28	S.D. 2340 - water
9/4	—
9/11	—
9/18	—
9/25	—
10/2	—
10/19	Drly 2500'
10/16	" 2725'

- 10/23- 5/1R 8"- 2727'
 10/30- U1R 8"- 2727'
 11/6- Wrlg 2740' 8"- 2718'
 11/13- " 2900'
 11/20- S.D. 2900'
 11/27- Wrlg 3227'
 12/4- Top chat 3625'
 fsg. 3655'
 12/11- S.D. 3670'
 12/23- fsg 3670'
 12/30- Wrlg 3760'
 1930
 1/8- 5"- ~~3670~~ 3740' Plg out
 1/15- 5"- 3723 Wrlg 3740'
 1/22- S.D. 3740'
 1/29- T.D. 3740' U1R 5"
 2/4- 5"- 3747- Wrlg 375-1
 2/11- 5"- 3767 Plg. out
 3772
 2/19- 5" cemented 3775'
 Wrlg. out cement.
 2/26 —
 3/5- Wrlg. 3835' in line
 3/12- Wrlg. 3892 in line
 small show gas at
 3841'
 3/19- Wrlg 3902 in line.
 3/26- Base line 3968'
 Wrlg. 3983

Map No. _____ Sec. 9 Twp. 34 R. 15

Well No. 1 - Welch Farm
Harris & Haun Company


_____ Ft. from N. Line

300 Ft. from S. Line

_____ Ft. from E. Line

300 Ft. from W. Line

1930

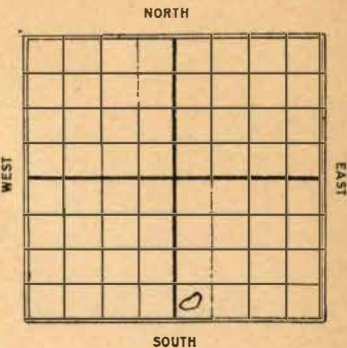

Date

REPORT

4/2

Sand 4003-4010
 1 bails water lv.

4/9

Dry.
 Top chat 3625
 Base line 3968
 Sand 4003-15 1/2'
 (MFW 4011) TD. 4015 1/2'

Abandoned

OWDD

1930

4/16

Old TD. 4015 1/2'
 Dry 4100'

4/23

" 4163'

4/30

" 4225'

5/7

S.D. 4270'

5/14

TD 4270'

Dry & Abandon

Summer

Map No. **KANSAS** Sec. *9* Twp. *34* R. *1 E*

Well No. *1 Welch*

Harris & Hawn Company

Contractor

CORRECTION

SECTION PLAT

..... Ft. from N. Line

300 Ft. from S. Line

..... Ft. from E. Line

300 Ft. from W. Line

		<i>0</i>	

Location.....

Rig up.....

Drilling and Remarks:

*by ownership
Ho above*

RECORD

Cased..... in., ft.

Sand.....

Gas.....

Oil.....

Total Depth.....

PRODUCTION

1st 24 hrs. Nat.....

1st 24 hrs. after shot.....

Gas..... Cu. Ft.

Dry Hole.....

Abandoned.....

Date

JAN 22 1930

CHAS. L. SHERWOOD

..... 192..... Scout

Summer

Map No. **KANSAS** Sec. *9* Twp. *34* R. *1*^E

Well No. *1* *Welch*

Harris & Haun Company

Contractor

COMPLETE

SECTION PLAT

..... Ft. from N. Line

300 Ft. from S. Line

..... Ft. from E. Line

300 Ft. from W. Line

		0	

ABANDONED

Location.....

Rig up.....

Drilling and Remarks:

Top Chat 3675
Base Line 3968

HW 4011

RECORD

Cased..... in., ft.
Sand *4003-4015 1/2*
Gas.....
Oil.....
Total Depth *4015 1/2*

PRODUCTION

1st 24 hrs. Nat.....
1st 24 hrs. after shot.....
Gas..... Cu. Ft.
Dry Hole
Abandoned.....

Date

APR 9 · 1930

.....192..... Scout

CHAS. L. SHERWOOD

Summer

Map No. **KANSAS** Sec. *9* Twp. *34* R. *1* ^{*E*}

Well No. *1* *Welch*

Harris & Haun Company

Contractor

FIRST REPORTS

SECTION PLAT

..... Ft. from N. Line

300 Ft. from S. Line

..... Ft. from E. Line

300 Ft. from W. Line

"old well deeper"

		<i>0</i>	

Location.....

old JD 4015 1/2

Drilling and Remarks:

Blg 4100'

RECORD

Cased..... in., ft.

Sand.....

Gas.....

Oil.....

Total Depth.....

PRODUCTION

1st 24 hrs. Nat.....

1st 24 hrs. after shot.....

Gas..... Cu. Ft.

Dry Hole.....

Abandoned.....

Date

APR 16 1930

CHAS. L. SHERWOOD

.....192.....

.....Scout

Summer

Map No. **KANSAS** Sec. 9 Twp. 34 R. 1 ^E

Well No. 1 Welch

Harris & Hanna Company

Contractor

COMPLETE

SECTION PLAT

_____ Ft. from N. Line

300 Ft. from S. Line

_____ Ft. from E. Line

300 Ft. from W. Line

ABANDONED

Location _____

Rig up _____

Drilling and Remarks:

RECORD

Cased _____ in., _____ ft.

Sand _____

Gas _____

Oil _____

Total Depth 4270

PRODUCTION

1st 24 hrs. Nat. _____

1st 24 hrs. after shot _____

Gas _____ Cu. Ft.

Dry Hole

Abandoned

Date 4 1930

CHAS. L. SHERWOOD

Summer

Map No. **KANSAS** Sec. 9 Twp. 34 R. 1^E

Well No. 1 Welch

Laredo Oil Co. Company

Contractor

FIRST REPORTS

SECTION PLAT

..... Ft. from N. Line

300 Ft. from S. Line

..... Ft. from E. Line

300 Ft. from W. Line

Location

Rig up

Drilling and Remarks:

RECORD

Cased..... in., ft.

Sand

Gas

Oil

Total Depth.....

PRODUCTION

1st 24 hrs. Nat.....

1st 24 hrs. after shot.....

Gas..... Cu. Ft.

Dry Hole.....

Abandoned.....

Date

MAY 29 1929

192

CHAS. L. SHERWOOD

Scout