

8/17/88 KCC

RELEASED
STATE CORPORATION COMMISSION OF KANSAS
OIL & GAS CONSERVATION DIVISION
WELL COMPLETION OR RECOMPLETION FORM
Date: ACO-1 WELL HISTORY
FROM CONFIDENTIAL
DESCRIPTION OF WELL AND LEASE

Operator: License # 4752
Name Source Petroleum
Address 910 Century Plaza Building
City/State/Zip Wichita, Kansas 67202

Purchaser Koch Oil Company
Wichita, KS

Operator Contact Person Phil Hargis
Phone 316-262-7397

Contractor: License # 5422
Name Abercrombie

Wellsite Geologist Phil Hargis
Phone 316-262-7397

Designate Type of Completion
 New Well Re-Entry Workover
 Oil SWD Temp Abd
 Gas Inj Delayed Comp
 Dry Other (Core, Water Supply etc.)

If OWN: old well info as follows:
Operator Wichita, Kansas
Well Name
Comp. Date Old Total Depth

WELL HISTORY


Drilling Method:
 Mud Rotary Air Rotary Cable
6-3-87 6-16-87 6-16-87
Spud Date Date Reached TD Completion Date
3700' 3647
Total Depth PBD

Amount of Surface Pipe Set and Cemented at 251 feet
Multiple Stage Cementing Collar Used? Yes No
If yes, show depth set feet
If alternate 2 completion, cement circulated from feet depth to w/ SX cmt
Cement Company Name B.J. Titan
Invoice #

API NO. 15-191,21,994
County Sumner
NW SE SW Sec. 3 Twp. 35 Rge. 1 East
990 Ft North from Southeast Corner of Section
3630 Ft West from Southeast Corner of Section
(Note: Locate well in section plat below)

Lease Name Bates Well # 5
Field Name Meek North
Producing Formation Simpson
Elevation: Ground 1124 KB 1136

Section Plat

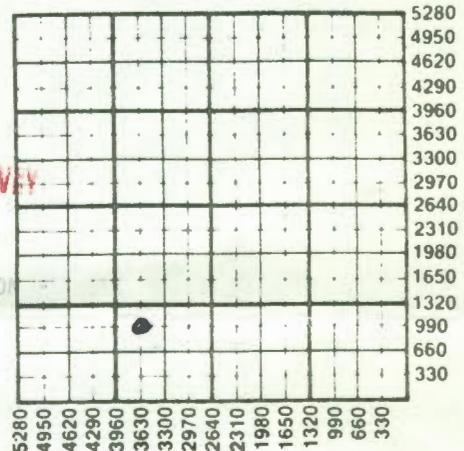

SEP 23 1988

KANSAS GEOLOGICAL SURVEY
WICHITA BRANCH

RECEIVED
STATE CORPORATION COMMISSION

AUG 17 1987

CONSERVATION DIVISION
Wichita, Kansas

WATER SUPPLY INFORMATION

Disposition of Produced Water: Disposal
Docket # Repressuring

Questions on this portion of the ACO-1 call:

Water Resources Board (913) 296-3717

Source of Water:
Division of Water Resources Permit #

Groundwater Ft North from Southeast Corner (Well) Sec 3 Twp 35 Rge 1 East West

Surface Water 1900 Ft North from Southeast Corner (Stream, pond etc) 3630 Ft West from Southeast Corner Sec Twp Rge East West

Other (explain) (purchased from city, R.W.D. #)

INSTRUCTIONS: This form shall be completed in triplicate and filed with the Kansas Corporation Commission, 200 Colorado Derby Building, Wichita, Kansas 67202, within 120 days of the spud date of any well. Rule 82-3-130, 82-3-107 and 82-3-106 apply. Information on side two of this form will be held confidential for a period of 12 months if requested in writing and submitted with the form. See rule 82-3-107 for confidentiality in excess of 12 months. One copy of all wireline logs and drillers time log shall be attached with this form. Submit CP-4 form with all plugged wells. Submit CP-111 form with all temporarily abandoned wells.

All requirements of the statutes, rules and regulations promulgated to regulate the oil and gas industry have been fully complied with and the statements herein are complete and correct to the best of my knowledge.

Signature Phillip E. Hargis
Title Geologist/Partner Date 8-1-87

Subscribed and sworn to before me this 1st day of August 1987.
Notary Public Paula K. Driskell

Date Commission Expires June 27, 1990

K.C.C. OFFICE USE ONLY
F Letter of Confidentiality Attached
C Wireline Log Received
C Drillers Timelog Received
Distribution
KCC SWD/Rep NGPA
KGS Plug Other (Specify)

PAULA K. DRISKELL
NOTARY PUBLIC
STATE OF KANSAS
My Appt. Exp. 6-27-1990

KANSAS GEOLOGICAL SURVEY
WICHITA BRANCH

8 1987

Sec 3 Twp 35 Rge 1 East