


Sumner

Section 6 Township 35 Range 1 EWell No. # 7 GurleyCompany Herndon

NORTH

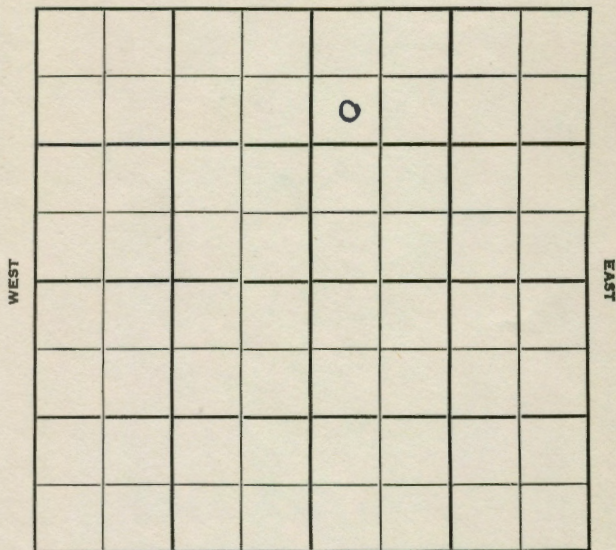

SOUTH

Sumner

KANSAS

Sec. 6 Twp. 35 R. 1EWell No. #7 GurleyCompany HerndonContractor Guelph

990 Ft. from N. Line


Ft. from S. Line

Ft. from E. Line

330 Ft. from W. Line

SW NW NE

NORTH

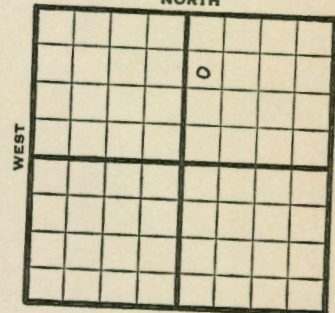

SOUTH

1952

Elev. 1094' REPORT

2/13 Spud 2-10-52
8" @ 368' WOC

2/20 Drlg. 3150'

3/4 Lay 2954 Lay Sd 2980 Simp Sd 3837
2nd Simp Sd 3871-84 Ero Arb. 3962
Arb. 3969 RTD 3986
5" @ 3969 DP GO to 3869
S/4 BOPH 500 A S/8 BOPH to DD3/19 Spud 2-10-52
Oil well TD 3993' 8" @ 368
Layton 2954' Layton sand 2980'
Simp. 3837' Re-Arb. 3962' Arb. 3969
TD 3986' 5" @ 3969 DP to TD
S/4 BOPH 500 A S/8 BOPH DD 3993'
FU 3000' oil 3 hr. S/14 BOPH 95% oil
Comp. 120 BOPD**COMPLETED**

