


Section 17 Township 35 Range 1 E

Well No. # 1 Hockney

Company Herndon Drlg.

NORTH

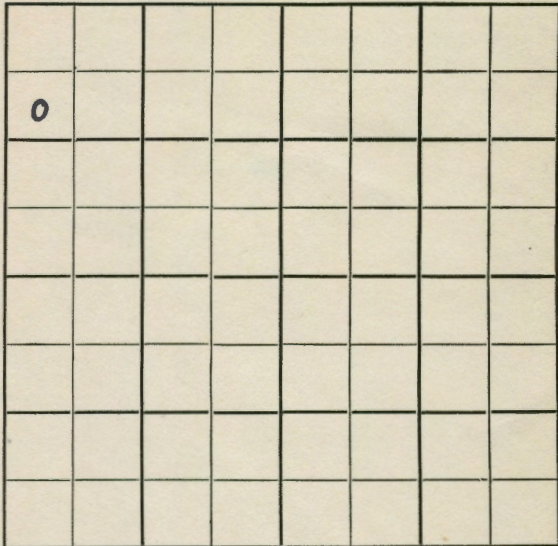

SOUTH

Sec. 17 Twp. 35 R. 1E

Well No. #1 Hockney Farm

Herndon Drlg. Company

Herndon Drlg. - Contr. Contractor

Wildcat

990' Ft. from N. Line


_____ Ft. from S. Line

_____ Ft. from E. Line

330' Ft. from W. Line

SW NW NW

NORTH

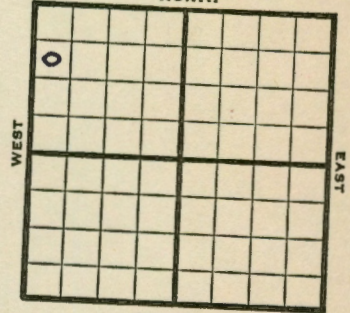

SOUTH

1952

Elev. 1080

REPORT

7/2

Location

7/9

Drlg 3652

7/17

NR

7/23

"

7/30

"

8/6

Spud 6-24-52

D&A TD 4015

8" @ 360 **Stal 2560**

Layton 2983

DST 2988-3003 opn 1 hr. Rec. 60'

180' wtr **Layton sd 2993**

Miss 3600 Woodford 3832

Simp 3891

DST 3891-97 opn 1/2 hr. Rec. 8' mud

DST 3916-25 opn 1/2 hr. Rec. 3' mud

TD 4015 D&A

ABANDONED

