


Section 6 Township 35 Range 1E

Well No. #12 Gurley

Company Herndon Drlg.

NORTH

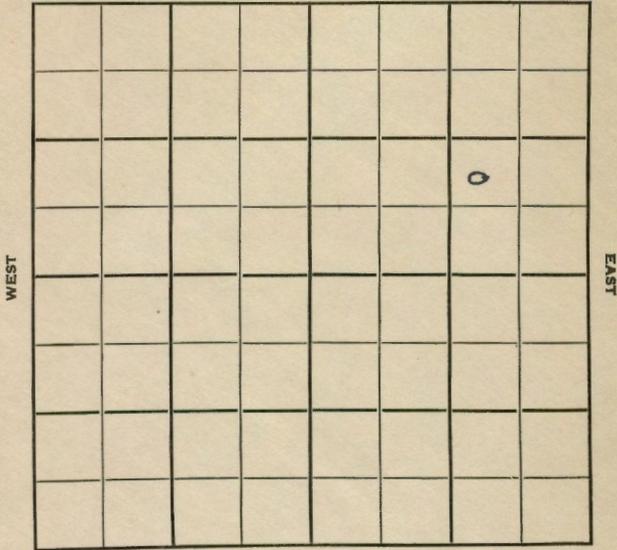

SOUTH

Sec. 6 Twp. 35 R. 1E

Well No. # 12 Gurley Farm

Herndon Drlg. Company

Herndon Drlg. Contractor

_____ Ft. from N. Line


970 Ft. from S. Line

990 Ft. from E. Line

_____ Ft. from W. Line

NW SE NE

NORTH

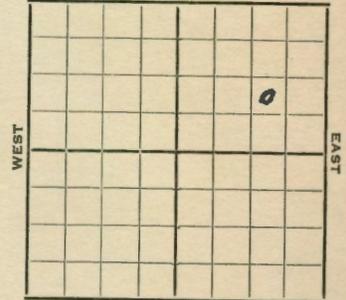

SOUTH

1952 **Elev. 1123'** REPORT

10/29 RUR

11/20 RTD 3062' 5" @ 3033' CO 3062
2 1/2 BOPH 5 BOPH

11/27 NR

12/3 Spud 10-28-52

Oil Well

TD3062

8" @ 350

Layton 2990, Layton sd. 3032',

5" @ 3033

TD 3062

2 1/2 boph sd-frac 5 boph

Comp. 193 bopd

COMPLETED

