


Section 6 Township 35 Range 1E

Well No. #2 Milligen

Company Herndon Drlg.

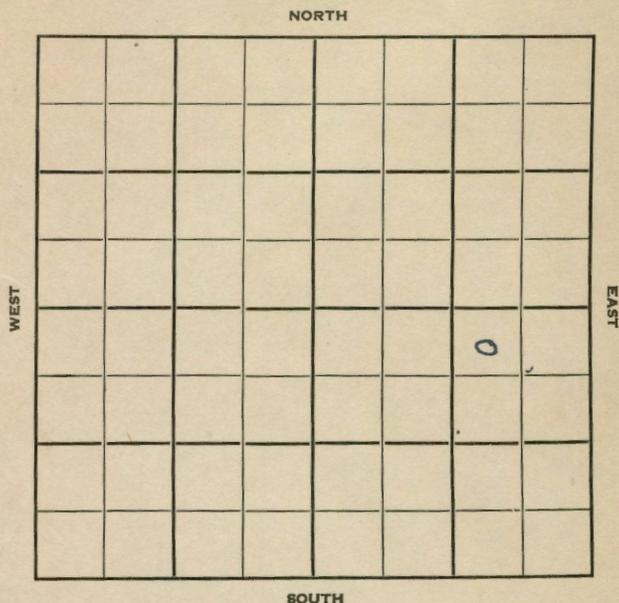

Sec. 6 Twp. 36 R. 1E

Well No. #2 Milligen Farm \_\_\_\_\_

Herndon Drlg. Company \_\_\_\_\_


Herndon Drlg. Contractor \_\_\_\_\_

330 Ft. from N. Line

\_\_\_\_\_ Ft. from S. Line

990 Ft. from E. Line

\_\_\_\_\_ Ft. from W. Line

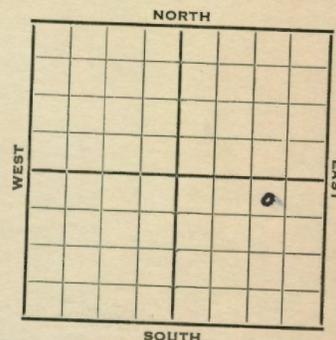

SE  $\frac{1}{4}$  NW NE SE

1952 **Elev. 1153'** REPORT

- 10/22 Drlg. 3286'
- 10/29 NR
- 11/5 "
- 11/12 **Miss 3683'** B. **Miss 3852'** **Simp. 3962'**  
RTD 3965' 5" @ 3962' Fish swab.
- 11/20 "
- 11/27 NR
- 12/4 "
- 12/11 NR
- 12/18 NR
- 12/25 NR
- 1/1 NR
- 1/8 NR
- 1/22 "
- 1/29 D & A - Hold
- 2/4 Spud 10-9-52  
D&A  
TD 3965  
8" @ 358  
**Miss 3683, B. Miss 3852, Simp 3962**  
TD 3965  
5" @ 3962  
60/3197-3222, S/ $\frac{1}{2}$  boph  
**Layton 3097**  
D&A

**ABANDONED**

County Sumner State Kansas  
 Sec. 6 (Blk. 35 (Sur. 1E (Twp. 1E) Map No.  
 Operator Herndon Drlg.  
 Well No. 2 Farm Milligen  
 Elev. \_\_\_\_\_ Location NW NE SE


330 Ft. From N Line SE  
990 Ft. From E Line Quarter  
 Ist. Report OCT 22 1952  
 Completion \_\_\_\_\_  
 Remarks \_\_\_\_\_  
Herndon Drlg. - Contr.  
 Spudding Date \_\_\_\_\_

Drlg. Data \_\_\_\_\_  
drlg. 3286

J. G. McGEHEE

County Sumner State Kansas  
 Sec. 6 (Blk. 35 (Sur. 1E (Twp. 1E) Map No.  
 Operator Herndon Drlg.  
 Well No. 2 Farm Milligen  
 Elev. 1153 Location NW NE SE


330 Ft. From N Line SE  
990 Ft. From E Line Quarter  
 Ist. Report \_\_\_\_\_  
 Completion FEB 4 1953  
 Remarks \_\_\_\_\_  
Herndon Drlg. - Contr.  
 Spudding Date 10-9-52

Drlg. Data D & A TD 3965  
8" @ 358 Miss. 3683 B. Miss. 3852  
Simp. 3962 TD 3965 5" @ 3962  
60/ 3197-3222 S/ 1/2 boph Layton 3097  
D & A

J. G. McGEHEE