
DX 78-1

Sumner KANSAS

Section 18 Township 35 Range 1 E

Well No. # 1 Brown

Company Alpine Oil & Royalty

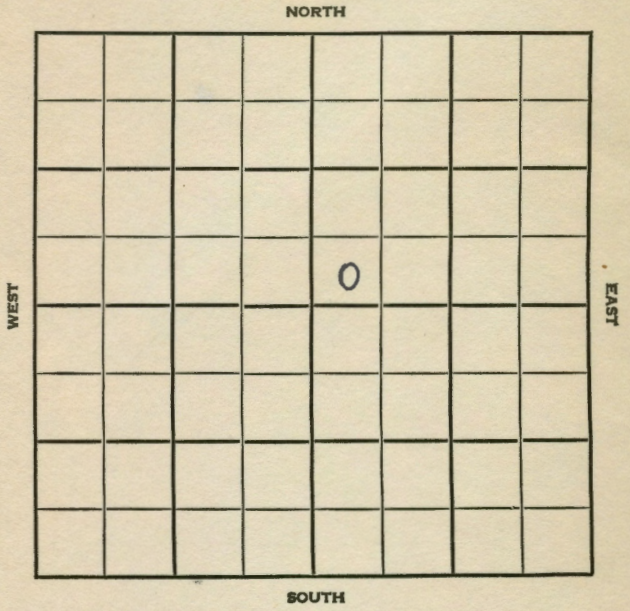

Sumner KANSAS

SEC.	TWP.	R.
18	35	1E

WELL NO. 1 Brown FARM

COMPANY Alpine Oil & Royalty


CONTRACTOR Quaker

_____ Ft. from N. Line

330 Ft. from S. Line

_____ Ft. from E. Line

330 Ft. from W. Line

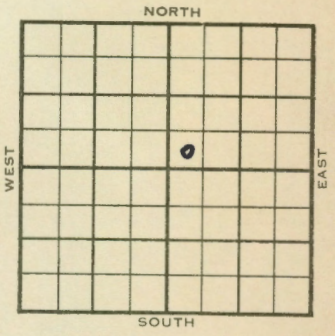

SW SW NE

	ELEVATION 1069' REPORT
1955	
3/16	Drlg. 3100'
3/30	Spud 3-19-55 D & A TD 3896 8" @ 204 Top. 1826 Stal. 2540 Layton 2992 KC 3154 Cleve 3288 Oswego 3344 Cherokee 3474 Bart 3524 Miss. 3584 DST 3592-3607 open 1 hr rec 33' mud Kh. 3809' Chattanooga 3838' Simp. 3869 DST 3891-96 open 1/2 hr, rec 15' mud 760# TD 3896 D & A ABANDONED

DX-78

FORM 275 FOR SALE BY KANSAS BLUE PRINT CO.


County Sumner State Kansas

Sec. 18 (Blk. Twp.) 35 (Sur. Rge.) 1E Map No.

Operator Alpine Oil & Royalty

Well No. 1 Farm Brown

Elev. Location SW SWNE

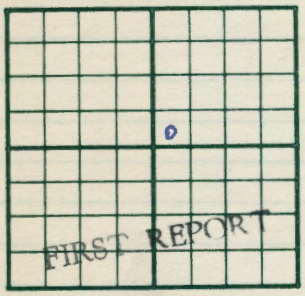

330 Ft. From S Line NE

330 Ft. From W Line Quarter

MAR 16 1955

1st. Report

Completion

Remarks Quaker - Contr.

Spudding Date

Drlg. Data

drlg. 3100

FABEN GILSTRAP

FORM 275 FOR SALE BY KANSAS BLUE PRINT CO.

County Sumner State Kansas

Sec. 18 (Blk. Twp.) 35 (Sur. Rge.) 1E Map No.

Operator Alpine Oil & Royalty

Well No. 1 Farm Brown

Elev. 1069 Location SW SW NE



330 Ft. From S Line NE

330 Ft. From W Line Quarter

1st. Report

Completion MAR 30 1955

Remarks Quaker - Contr.

Spudding Date 3-19-55

Drlg. Data D & A TD 3896

8" @ 204 Top. 1826 Stal. 2540

Layton 2992 KC 3154 Cleve. 3288

Oswego 3344 Cherokee 3474 Bart. 3524

Miss. 3584 DST 3592-3607 open 1 hr.

Rec. 33' mud 0# Kh. 3809

Chattanooga 3838 Simp. 3869 DST 3891-96

open ½ hr. Rec. 15' mud 760# TD 3896

D & A

FABEN GILSTRAP