


Map No. Kansas Sec. 18 Twp. 35 R. 1E
 Well No. 1 Hamilton Farm
Amerada Pet Company

NORTH

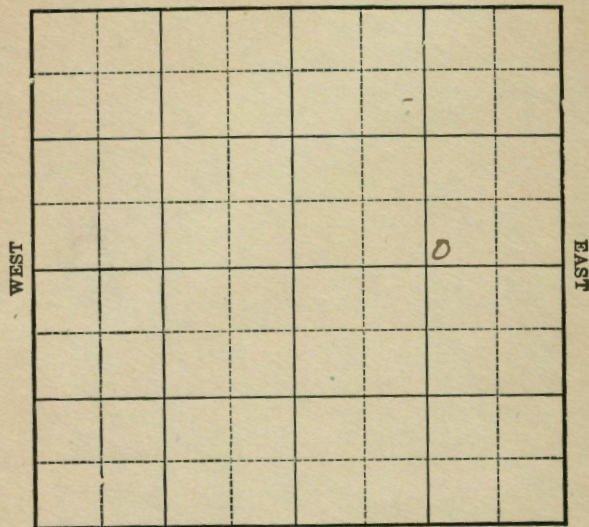

SOUTH

Location _____
 Drilling Remarks _____

Rig Up _____
 Drilling Remarks _____

RECORD


Cased _____ in. _____ ft.
 Sand _____
 Gas _____
 Oil _____
 Total Depth _____

PRODUCTION

1st 24 hrs. Nat. _____
 1st 24 hrs. after shot _____
 Gas _____ cu. ft.
 Dry Hole _____
 Abandoned _____

Map No. Kansas Sec. 18 Twp. 35 R. 1E
 Well No. 1 Hamilton Farm
Amerada Pet Company

NORTH

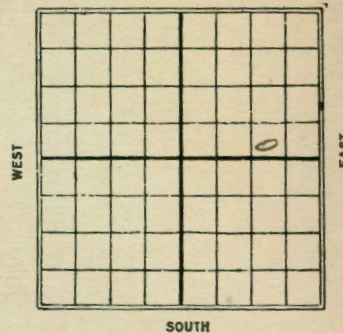

SOUTH

_____ Ft. from N. Line
300 Ft. from S. Line
990 Ft. from E. Line
 _____ Ft. from W. Line

Date

REPORT

1926
5/5 R.O.G.
5/12 Rig
5/19 Rigging up.
5/26 Spud.
6/2 T.D. 190 fishing bit
6/9 same
6/16 Dlg 230
6/23 " 475
6/30 " 885
7/14 fishing 1300 T.D.
7/22 _____
8/11 16 M. gas 2280-2293-S.D.
8/18 40 M Gas 2315-2320-T.D.
8/25 trying to shut off
gas. 2315-20
9/1 trying to pull pipe
froze
9/8 Dlg 2320
9/15 " 2640
9/22 Show oil 2615-bulg 2960
9/29 no report
10/6 3190-S.D. High water

Map No. KANSAS Sec. 18 Twp. 35 R. 1EWell No. 1 HamiltonCrescenta Pet. Company

Contractor

SECTION PLAT

Ft. from N. Line

300 Ft. from S. Line990 Ft. from E. Line

Ft. from W. Line

FIRST REPORTS

Location

Rig up

Drilling and Remarks:

ROG.

RECORD

Cased _____ in., _____ ft.

Sand _____

Gas _____

Oil _____

Total Depth _____

PRODUCTION

1st 24 hrs. Nat. _____

1st 24 hrs. after shot _____

Gas _____ Cu. Ft.

Dry Hole _____

Abandoned _____

Date

MAY 5 - 1926192S. J. LEWIS

Scout

10/13 - Drlg 3350'
 10/20 - top chat 3595-
 sho oil & gas
 Drlg 3670 - H.F.W.

10/27 - 2.D. 3675 swedging 6"

11/3 - J.D. 3675 - Drlg up
6" pipe

11/10

11/17 - Drlg 3684 - show
oil & water

11/24 - J.D. 3684 trying to shut off water

12/1 - Drlg 3696

12/8 - T.D. 3720' Cement 6" pipe

12/15 - same

12/21 - Drlg. out Cement fishing bailer

12/29 - Drlg. 3745

1927

1/5 - Drilling 3795

1/12 - Wilcox 3883 H.F.W.

T.D. 3893

1/19 - Plugging back to gas sand
2320 -

1/26 - same

2/2 - P.B. to 2400

2/9 - same

2/16 - 10" - collapsed

4/23

3/2

3/9

3/16

3/23

3/30 - Del 6 5/8" @ 2119 - hole P.B.
to 2157 - 8 1/3 m gas - tested -

4/6 - Top sand 2057

T.D. 2119

8,300,000 gas

MAP No. K1 SEC. 18 TWP. 35S R. 1E

WELL No. Hamilton

Amerenda COMPANY

CONTRACTOR

SECTION PLAT

_____ Ft. FROM N. LINE

_____ Ft. FROM S. LINE

_____ Ft. FROM E. LINE

_____ Ft. FROM W. LINE

LOCATION _____

RIG UP _____

DRILLING AND REMARKS:

P.B.
2286-2320
8 1/2" M gas

RECORD

CASED _____ IN. _____ FT.

SAND _____

GAS _____

OIL _____

TOTAL DEPTH 3893

PRODUCTION

1ST 24 HRS. NAT. _____

1ST 24 HRS. AFTER SHOT _____

GAS 8 1/2" M Cu. Ft.

DRY HOLE _____

ABANDONED _____

DATE

1/5 1917 SCOUT

MAP No. 18 SEC. 18 TWP. 35 R. 1E

WELL No. Hamilton

Amerenda P.D. Company

Contractor

SECTION PLAT

_____ Ft. from N. Line

300 Ft. from S. Line

990 Ft. from E. Line

_____ Ft. from W. Line

COMPLETED

Location _____

Rig up _____

Drilling and Remarks:

Top Sand 2057

TI 2119

8,300,000 Gas.

RECORD

Cased _____ in., _____ ft.

Sand _____

Gas _____

Oil _____

Total Depth _____

PRODUCTION

1st 24 hrs. Nat. _____

1st 24 hrs. after shot _____

Gas _____ Cu. Ft.

Dry Hole _____

Abandoned _____

Date

APR 6 1927 192 S. J. LEWIS Scout