


Sumner County

Section 18 Township 35 Range 1E

Well No. #1 Horsley

Company J. Trigg et al Fred Horton

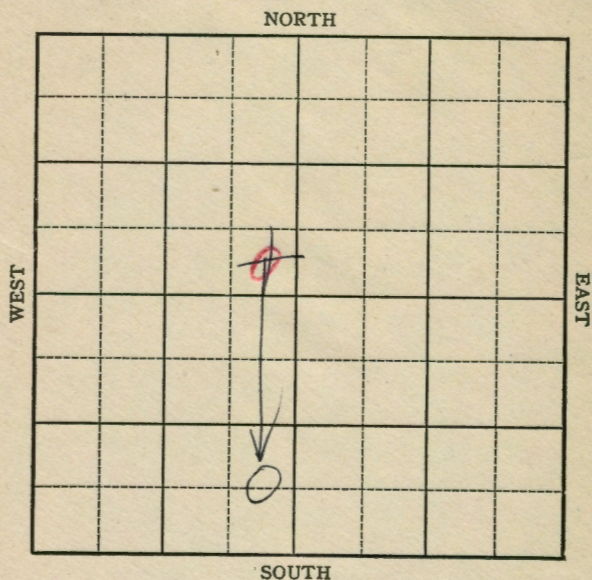

KANSAS

Sumner County

Sec. 18 Twp. 35 R. 1E

Well No. #1 Horsley Farm

J. Trigg et al Fred Horton Company

Miscellaneous


Ft. from N. Line

330 660 Ft. from S. Line

330 Ft. from E. Line

Ft. from W. Line

SE NW CEL SE SW

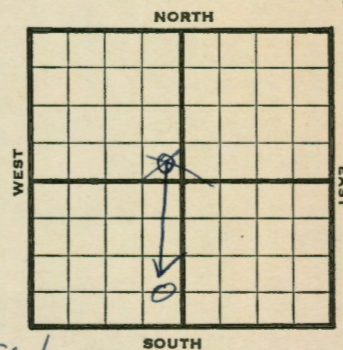

1946 Elev. 1094 REPORT

7/17 Location
7/23 10" @ 179
Drlg 3082'
7/30 Miss 3612
Drlg 3700'


8/7 Simp sd. 3880
TD 3894'

ABANDONED

Kansas Pool Name Miscellaneous
 Map No. 1 Sec. 18 Twp. 35 R. 1E
 Well No. 1 Horsley
J. Trigg etal. Company
FIRST REPORT Contractor

SE NW

SECTION PLAT

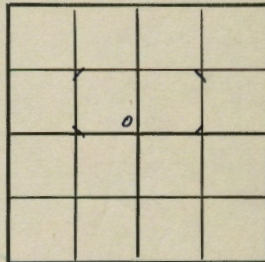

Ft. from N. Line
330 Ft. from S. Line
330 Ft. from E. Line
 Ft. from W. Line

Sumner County

Location X

Rig up

Drilling and Remarks:

RECORD

Cased in., ft.
 Sand
 Gas
 Oil
 Total Depth

PRODUCTION

1st 24 hrs. Nat.
 1st 24 hrs. after shot
 Gas Cu. Ft.
 Dry Hole
 Abandoned


Date

JUL 17 1946 19 S. J. LEWIS Scout

Kansas Pool Name Miscellaneous
 Map No. 1 Sec. 18 Twp. 35 R. 1E
 Well No. 1 Horsley
Fred Horton Company
CORRECTION Contractor

C E L SE SW

SECTION PLAT

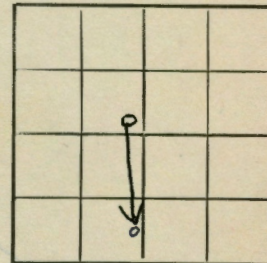

Ft. from N. Line
660 Ft. from S. Line
330 Ft. from E. Line
 Ft. from W. Line

Sumner
Cowley County

Location

Rig up

Drilling and Remarks:

Reported

J. Trigg etal.

SE NW

RECORD

Cased in., ft.
 Sand
 Gas
 Oil
 Total Depth

PRODUCTION

1st 24 hrs. Nat.
 1st 24 hrs. after shot
 Gas Cu. Ft.
 Dry Hole
 Abandoned

Date

JUL 24 1946 19 S. J. LEWIS Scout

KANSAS


Kansas

Pool Name MiscellaneousMap No. 1 Sec. 18 Twp. 35 R. 1EWell No. 1 HorsleyFred Horton Company**ABANDONED**

Contractor

C E L SE SW

SECTION PLAT

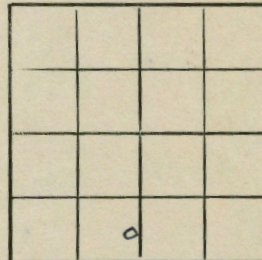 Ft. from N. Line660 Ft. from S. Line330 Ft. from E. Line Ft. from W. LineSumner CountyLocation Rig up

Drilling and Remarks:

Simple Sol 3894**RECORD**Cased in., ft.Sand Gas Oil Total Depth 3894**PRODUCTION**1st 24 hrs. Nat. 1st 24 hrs. after shot Gas Cu. Ft.Dry Hole Abandoned

Date

AUG 7 1946

19

S. J. LEWIS

Scout