
Sumner

KANSAS

SECTION 18 TOWNSHIP 35 RANGE 1E

WELL NO. #1 Kerr

COMPANY Divanco (Ponca City)

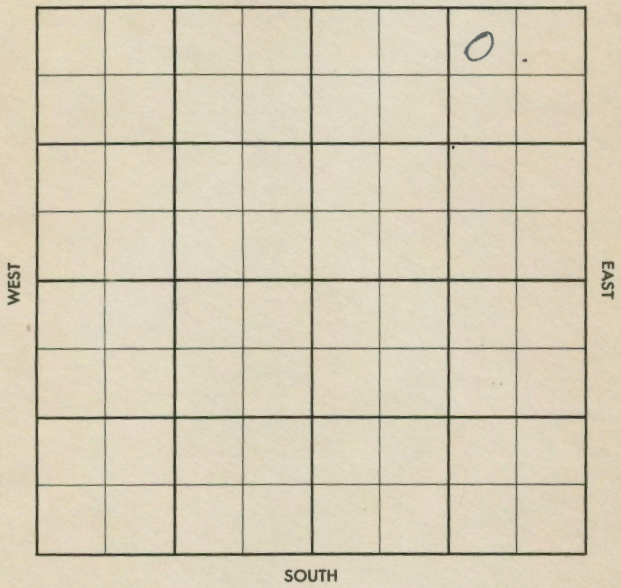

FORM 504-3 SUNRAY

FORM 513 SUNRAY

County Sumner Elev. 1096

Sec. 18 Twp. 35 Rge. 1E

Company Divanco (Ponca City)

Farm Name Kerr No. 1

TOPS	DEPTH	LOG	DATUM
Anh.			
Tp. Stall	2626		
H. Lay	3020		
Tr.			
Dg.			
Bl.			
L.			
K.C.	3206		
B.K.C. OSW	3374		
Ce.			
C.			
M. chert	3627		
M. Ll	3644		
K.			
Mz.			
Mc.			
V.			
S.			
S.			
A			
R.			
Pe.			
G.			
T.D.	3658		

Loc. in Sec. NW NE NE

Geol.

Contr. Uhl Tools

Pool

ABANDONED

JAN 16 '57

Lse. No. Sec. T. R.

Date Comm. 12-24-56 JAN 2 '57

8 5/8 148/100

IP 1998 JAN 9 '57 IP 3130

JAN 16 '57 DST 3633-42 2 hrs

rec 5' Md OHP 330/20"

DEA

FORM 513 SUNRAY

County Sumner Elev.

Sec. 18 Twp. 35 Rge. 1E

Company Divanco (Ponca City)

Farm Name Kerr No. 1

TOPS	DEPTH	LOG	DATUM
Anh.			
Tp.			
H.			
Tr.			
Dg.			
Bl.			
L.			
K.C.			
B.K.C.			
Ce.			
C.			
M.			
M.			
K.			
Mz.			
Mc.			
V.			
S.			
S.			
A			
R.			
Pe.			
G.			
T.D.			

Loc. in Sec. NW NE NE

Geol.

Contr. Uhl Tools

Pool

DEC 28 '56

FIRST REPORT

Date Comm. 12-24-56

29