


Section 6 Township 35 Range 1E

Well No. #9 Gurley

Company Herndon Drlg.

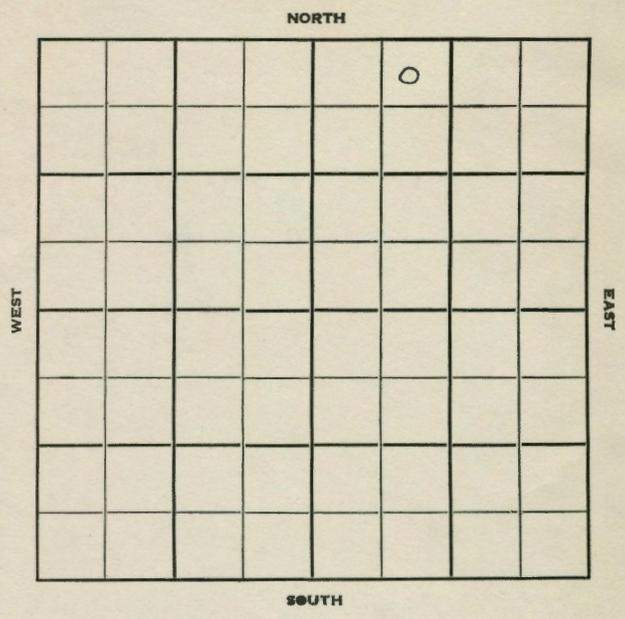

Sec. 6 Twp. 35 R. 1E

Well No. #9 Gurley Farm

Herndon Drlg. Company

Herndon Drlg. Contractor

Guelph Pool


330 Ft. from N. Line

_____ Ft. from S. Line

_____ Ft. from E. Line

990 Ft. from W. Line

NE NW NE

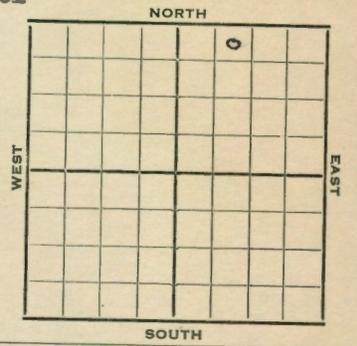

1952 **Elev. 1098'** REPORT

- 4/22 MIM
- 4/30 8" @ 356
Drlg. 1786'
- 5/7 **Lay 2982** TD 2997
5" @ 2984 WOCT
- 5/14 TD 3044' S/ 4 boph POP
- 5/21 Spud 4-22-52
Oil Well TD 3044 8" @ 356
Layton 2982
5" @ 2984 TD 3044 S/ 4 boph
Comp. 75 bopd

COMPLETED

