



Section 6 Township 35 Range 1E
 Well No. #10 Gurley
 Company Herndon Drlg.

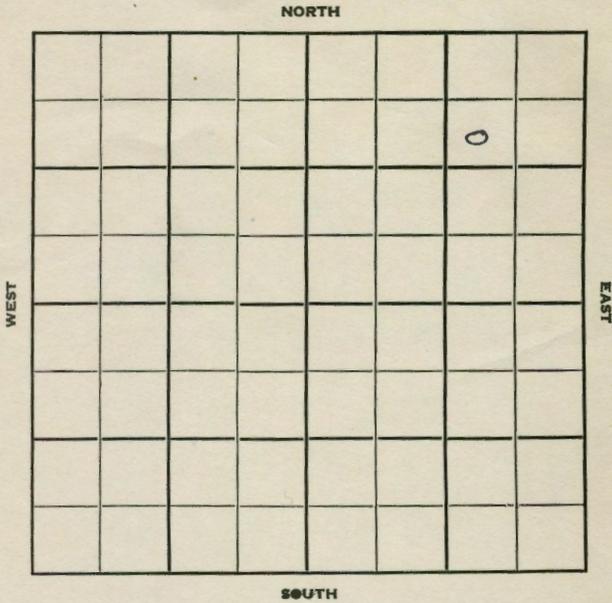

Sec. 6 Twp. 35 R. 1E
 Well No. #10 Gurley Farm
Herndon Drlg. Company
Herndon - Contr. Contractor
Gealph

990' Ft. from N. Line
 _____ Ft. from S. Line
990' Ft. from E. Line
 _____ Ft. from W. Line

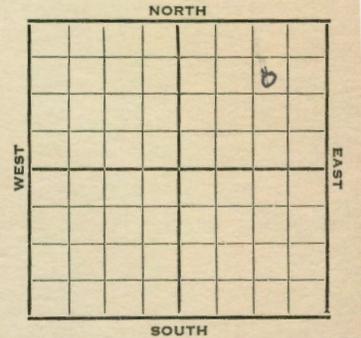

SW NE NE

1952 **Elev. 1109** REPORT

5/7 Spud 5-4-52
8" @ 337
WOC
 5/14 **Lay 3003' RTD 3015'**
5" @ 3004' WOC
 5/21 TD 3055' S/ 2 1/2 Boph POP
 5/28 NR
 6/11 "
 6/18 "
 7/2 "
 7/9 60 BOPD & 10% wtr
 7/17 NR
 7/23 "
 7/30 "
 8/6 Spud 5-4-52
Oil Well TD 3055
8" @ 337
Layton 3003 TD 3015
5" @ 3004 DD 3055
S/2 1/2 boph Comp. 522 bopd

COMPLETED

