


Section 6 Township 35 Range 1E

Well No. #14 Gurley

Company Herndon Drlg.

NORTH

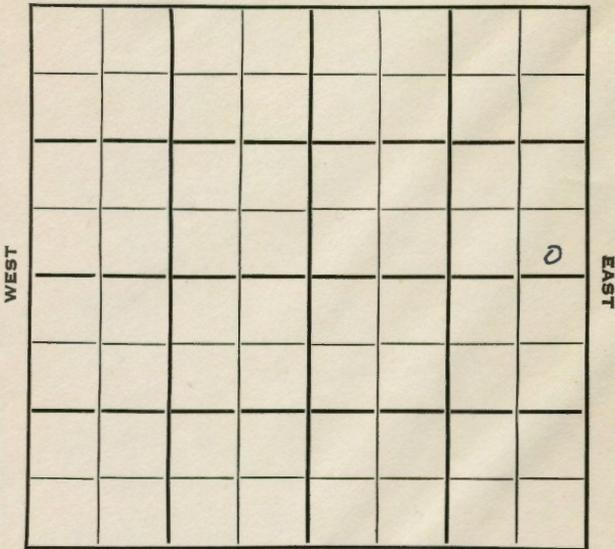

SOUTH

Sec. 6 Twp. 35 R. 1E

Well No. #14 Gurley Farm _____

Herndon Drlg. Company _____

Herndon Drlg. Contractor _____

_____ Ft. from N. Line


330 Ft. from S. Line

330 Ft. from E. Line

_____ Ft. from W. Line

SE SE NE

NORTH

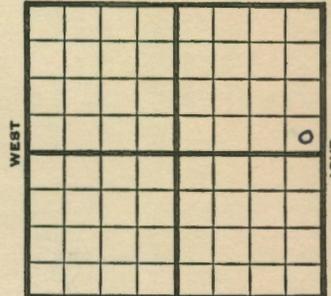

SOUTH

1953

Elev. 1159'

REPORT

2/18

R U R

4/1

Spud 2-18-53 Oil well TD 3967

8" @ 353 Miss. 3700 Kh. 3836

Simp. 3946 TD 3955 5" @ 3948

DD 3967 S/116 BO 16 hr.

Comp. 170 BOPD

COMPLETED

