


Section 6 Township 35 Range 1E

Well No. #17 Gurley

Company Herndon Drlg.

NORTH

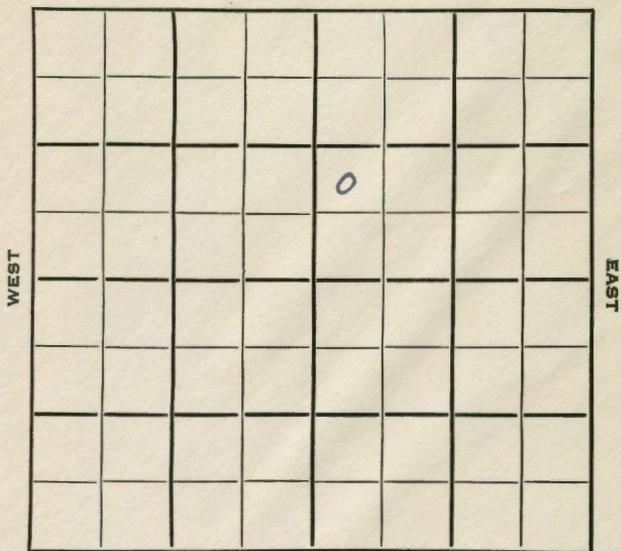

SOUTH

Sec. 6 Twp. 35 R. 1E

Well No. #17 Gurley Farm

Herndon Drlg. Company

Herndon Drlg. Contractor

Guelph Pool

Ft. from N. Line


990 Ft. from S. Line

Ft. from E. Line

330 Ft. from W. Line

NW SW NE (100' NE  
Twin to #2)

NORTH

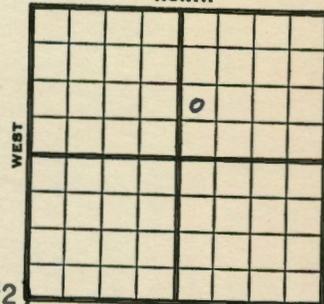

SOUTH

1953 **Elev. 1099'** REPORT

4/8 Spud 4-2-53  
8" @ 354  
Drlg. 2250'

5/27 Spud 4-2-53  
Oil Well  
TD 3034  
8" @ 354  
**Layton 3007**  
TD 3015  
5" @ 3007  
DD 3034 1 boph oil-frac  
F/16 boph  
Comp. 126 bopd 12% wtr.

**COMPLETED**



