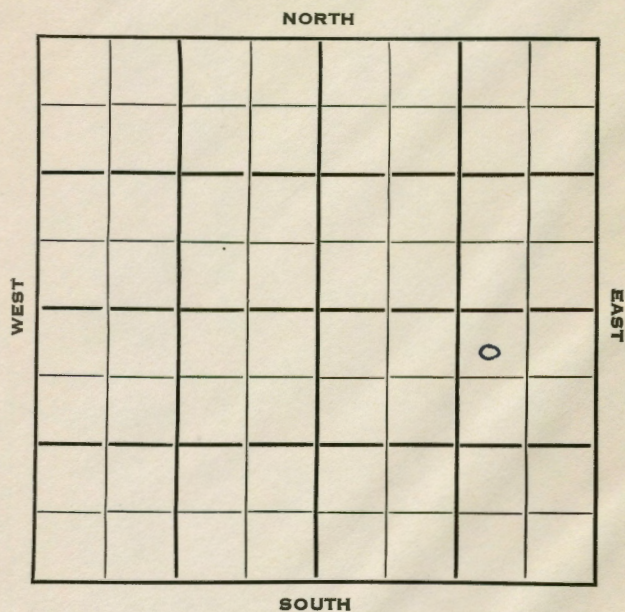


KANSAS

Section 6 Township 35 Range 1EWell No. 2-A MilliganCompany Herndon Drlg.

Sumner

KANSAS


Sec. 6 Twp. 35 R. 1EWell No. 2-A Milligen FarmHerndon Drlg. CompanyHerndon Drlg. Contractor330 Ft. from N. Line

Ft. from S. Line

1130 Ft. from E. Line

Ft. from W. Line

NW NE SE

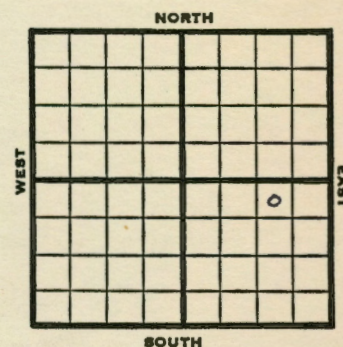

1953 Elev. 1153' REPORT

1/7 Simp 3959-65  
TD 3965  
5" @ 3960

2/4 Oil Well  
TD 3968  
Simp 3959  
TD 3968  
5" @ 3960  
CO to 3968  
S/10 boph P/5 boph  
Comp. 1145 bopd

COMPLETED



|          |               |             |          |                |
|----------|---------------|-------------|----------|----------------|
| County   | Summer        |             | State    | Kansas         |
| Sec.     | 6             | (Blk. Twp.) | 35       | (Sur. Rge.) 1E |
| Operator | Herndon Drig. |             |          |                |
| Well No. | 2-A Farm      |             | Milligen |                |
| Elev.    | 1153          | Location    | NW NE SE |                |

0

COMPLETE

|                        |     |      |         |
|------------------------|-----|------|---------|
| 330 Ft. From           | N   | Line | SE      |
| 1130 Ft. From          | E   | Line | Quarter |
| 1st. Report            |     |      |         |
| Completion             | FEB | 4    | 1953    |
| Remarks                |     |      |         |
| Herndon Drlg. - Contr. |     |      |         |
| Spudding Date          |     |      |         |

|                |            |           |
|----------------|------------|-----------|
| Drig. Data     | Oil well   | TD 3968   |
| Simp. 3959     | TD 3968    | 5" @ 3960 |
| CO to 3968     | S/ 10 boph | P/ 5 boph |
| Comp. 145 bopd |            |           |

J. G. McGEHEE

|          |               |                  |          |                             |
|----------|---------------|------------------|----------|-----------------------------|
| County   | Summer        |                  | State    | Kansas                      |
| Sec.     | 6             | (Blk.)<br>(Twp.) | 35       | (Sur.)<br>(Rge.) 1E Map No. |
| Operator | Herndon Drlg. |                  |          |                             |
| Well No. | 2-A Farm      |                  | Willigen |                             |
| Elev.    | Location      |                  | NW NE SE |                             |

FIRST REPORT

330 Ft. From N Line SE  
1130 Ft. From E Line Quarter  
1st. Report JAN 7 1953  
Completion \_\_\_\_\_  
Remarks \_\_\_\_\_  
Herndon Drlg. - Contr.  
Spudding Date \_\_\_\_\_

Drlg. Data

|               |         |           |
|---------------|---------|-----------|
| Simp. 3959-65 | TD 3965 | 5" @ 3960 |
|---------------|---------|-----------|

J. G. McGEHEE