

Summer


KANSAS
1E

SECTION 10 TOWNSHIP 35 RANGE

WELL NO. #1 G. C. Meek

COMPANY Pure Oil

NORTH

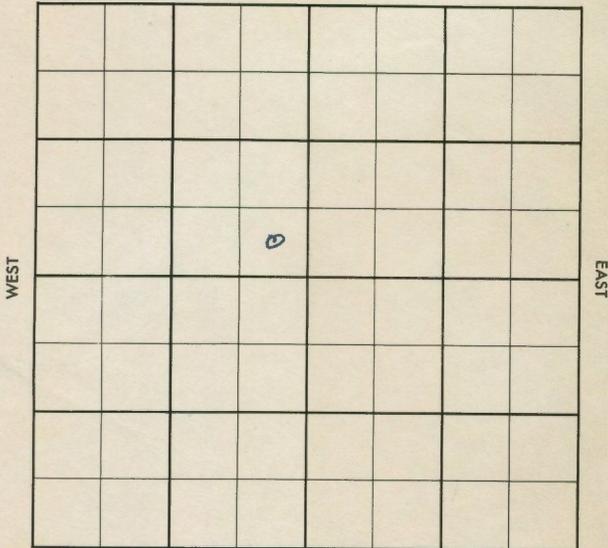

SOUTH

Summer

KANSAS

SEC. 10 TWP. 35 R. 1E

WELL NO. #1 G.C. Meek FARM

COMPANY Pure Oil

CONTRACTOR Creighton

WILDCAT

_____ Ft. from N. Line


_____ Ft. from S. Line

_____ Ft. from E. Line

_____ Ft. from W. Line

SE SE NW

NORTH

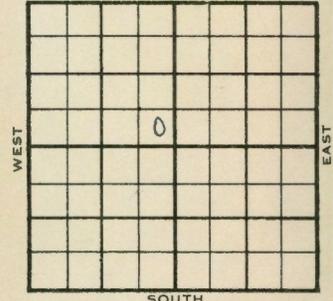

SOUTH

	ELEVATION	REPORT
1956	1142'	

4-11- RUR

6-6 Comm. 4-10-56
 8 5/8" @ 363 w/250
 DST 2191-2239 op 1 hr. rec. 45' mud,
 / 680 SW, FP 55-315, BHP 635/20"
 DST 3220-50 op 1 hr. ~~xxx~~ 300' GIP,
 rec. 65' SO&HGCM, BHP 170/20".
 DST 3498-3530 op 1 hr. rec. 50' SO
 spk. mud / 300' msw, BHP 1610/20".
 4 1/2" @ 3289 w/150
 CO 72/3228-46
 S/ 76 BO / 65 BSW in 9 hrs.
 P/ 45 BO / 60 BW - 24 hrs.,
 Grav. 35
 Hoov. 2190', Stall 2426', Stall Sd 252
 Lay. 2852', KC 3070', Clev sd 3220'
 Osw. 3303', Ce. 3426', Skin. sd. 3497
 Miss. 3570', ~~Chata~~ S. 3803', A. 3923'.
 Log tops:
 Hoov. 2188', Stall 2458', Stall Sd. &
 2504', Lay 2912', KC 3122', ~~x&x&x~~.
 Cleve. sd. 3219, Osw. 3298', Ce. 3429'
 Skin sd. 3500', Miss. 3570', K. 3724',
 Chata 3766' ● S. 3798', A. 3918'.
 TD 3949'

DX-78

COMPLETED

County Sumner Elev. 1142
 Sec. 10 Twp. 35 Rge. 1E
 Company Pure Oil
 Farm Name G. C. Meek No. 1

TOPS	DEPTH	LOG	DATUM	Loc. in Sec.
Ank				SE SE NW
Tr. <u>Hwy.</u>	<u>2190</u>	<u>2188</u>		
H.				
Tr. <u>Stall</u>	<u>2426</u>	<u>2458</u>		
Dg. <u>" sd</u>	<u>2520</u>	<u>2504</u>		
Bl. <u>Log</u>	<u>2852</u>	<u>2912</u>		
L.				Geol.
K.C.	<u>3070</u>	<u>3122</u>		
B.K.C. <u>Clev sd</u>	<u>3220</u>	<u>3219</u>		Contr.
Cr. <u>OSW</u>	<u>3303</u>	<u>3298</u>		
Gr. <u>ce</u>	<u>3426</u>	<u>3429</u>		Creighton
M. <u>SKIN sd</u>	<u>3497</u>	<u>3500</u>		
M. <u>155</u>	<u>3570</u>	<u>3570</u>		Pool
K.		<u>3724</u>		
Mz. <u>chata</u>		<u>3766</u>		Wildcat
Me.				
V.	<u>3803</u>	<u>3798</u>		
S.				
A.	<u>3923</u>	<u>3918</u>		
R.				
PE.				
G.				
TD.	<u>3949</u>			

Date Comm. JUN 6 1956
RUP APR 18 4-10-56 858
363/260 DST 2191-2239 1hr
rec 45' Md + 680 SW EP 56
-315 BHP 635/20 APR 25 56
DST 3220-50 1hr a 300' GIP
rec 65' 50' HGCM BHP 170/20
DST 3498-3530 1hr rec 50' 50' SPK
Md + 300' MSW BHP 1610/20"
D 3607 MAY 2 56 4 1/2 @ 3289/150 MAY 9 56

10-35-1E

CO 72/3228-46 Frac #
76 B0 + 65 BSW in 9 hrs
 MAY 15 '56 MAY 20 '56 MAY 29 '56 JUN 6 '56

Prod 45 B0 + 60 Bw - 24 hr. 42" dia
13 Pmi. sp. 35°

County Summer Elev. _____
 Sec. 10 Twp. 35 Rgs. 1E
 Company Pure Oil
 Farm Name G. C. Meek No. 1

TOPS	DEPTH	LOG	DATUM	Loc. in Sec.
Anh.				SE SE NW
Top.				
H.				
Tr.				
Dg.				
Bl.				
L.				Geol. _____
K.C.				Contr. _____
B.K.C.				
Ce.				Creighton
C.				
M.				Pool
M.				Wildcat
K.				
Mz.				
Ma.				
V.				
S.				
S.				
A.				
R.				
Pe.				
G.				
T.D.				

APR 1 1958
 FIRST REPORT

Date Comm. RUR

~~20~~

APR 1 1958

R.G.

Co.
 No.
 Ser.
 T.
 R.