


Section 11 Township 35 Range 1 E

Well No. # 3 Skibbe "A"

Company Alpine Oil & Royalty

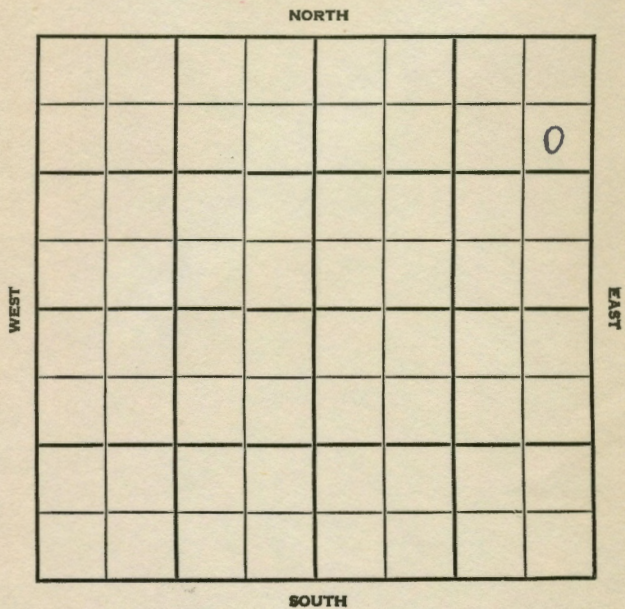

SEC. 11 TWP. 35 R. 1E

WELL NO. #3 Skibbe "A" FARM

COMPANY Alpine O & R.

CONTRACTOR


990 Ft. from N. Line

Ft. from S. Line

330 Ft. from E. Line

Ft. from W. Line

SE NE NE

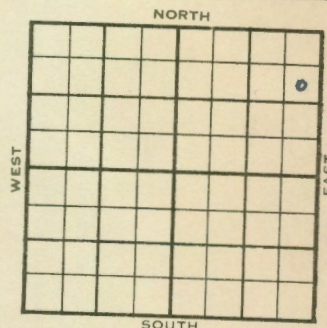

1954

ELEVATION

1103'

REPORT

12/15 Spud 12-15-54

M I R

3/16 Spud 12-15-54, Oil Well; TD 3490
 8 5/8" @ 140, Stal 2376, Layton
 2827, KC 3028, Cleve 3127,
 Oswego 3215, Bart 3417, Miss
 3477, TD 3490
 5" @ 3485, CO to 3490, FU 3300'
 Oil 2 hr
 Comp P & F/150 bopd

COMPLETED

