



Section 11 Township 35 Range 1 E
 Well No. # 4 Skibbee "A" (Skibbe)
 Company Alpine Oil & Royalty

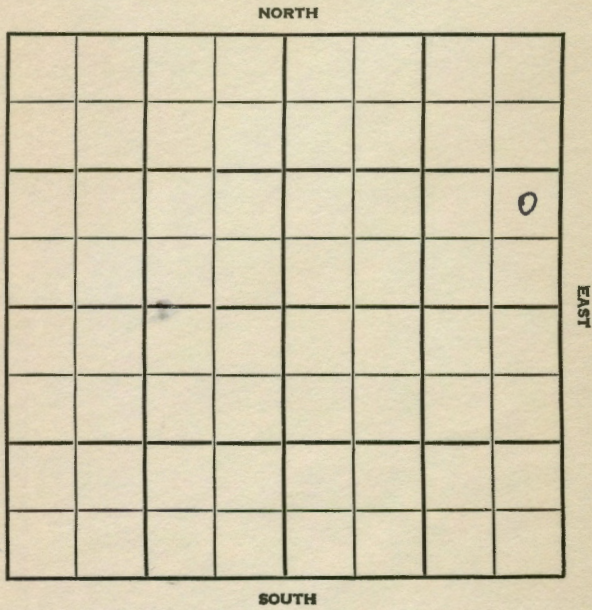

SEC. 11 TWP. 35 R. 1 E
 WELL NO. # 4 Skibbee "A" FARM
 COMPANY Alpine Oil & Royalty
 CONTRACTOR Quaker

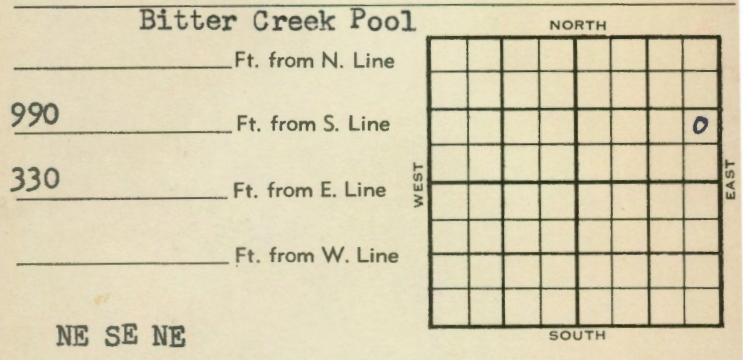

	ELEVATION	REPORT
1955	1102'	
1/26	Location	
3/16	Spud 1-27-55, Oil Well, TD 3498 8" @ 140, KC 3037, Cleve 3126, Oswego 3216, Bart 3422, Miss 34 3481, TD 3498, 5" @ 3493, CO to 3498 FU 500' oil 1 hr FU 1000' oil 2 1/2 hr Comp P & F 108 BOPD	

COMPLETED

