

11-35-1

WELL RECORD

WELL NO. 1 ON Frank L. Hall LEASE ACRES
SECTION 11 TOWNSHIP 35S RANGE 1 E COUNTY, Sumner
Drilling Commenced 1st 24 Hrs. Production—Natural Bbls.
Drilling Completed 2nd 24 Hrs. Production—Natural Bbls.
After Shot
Contractor^s Waite & Gibson 1st 24 Hrs. Production Bbls.

Formation	Top	Bottom	Thickness	REMARKS Indicate Showing of Oil Gas, Water and describe Formation
Surface	0	5		
White Slate	5	95		
Gypsy	95	100		
Slate	100	110		
Granite	110	115		
Broken Lime	115	128		
White Lime	128	135		
Black Shale	135	156		
Pink Rock	156	160		
Slate	160	195		
Gypsy	195	210		
Slate	210	265		
Lime	265	350		
Lime	350	355		
Lime	355	380		
Lime	380	395		
White Slate	395	410		
Lime	410	435		
Lime	435	460		
Lime	460	480		
Lime Broken	480	500		
Hard Lime	500	510		
Lime	510	517		
Gypsy Rock	517	532		
Lime	532	545		
Blue Shale	545	550		
Hard Lime	550	570		
Sand Lime	570	590		
Shale	590	595		
Blue Shale	595	600		
Sand Shale	600	623		
Red Rock	623	633		
Red Rock	633	643		
Blue Shale	643	648		
Lime Hard	648	658		
Lime Hard	658	680		
Lime	680	685		
Sand Water	685	698		Sand water at 690'
Lime	698	715		
Lime	715	755		
Lime	755	810		
Red Rock	810	867		
Red Rock	867	906		
Lime	906	920		
Blue Shale	920	965		
Hard Lime	965	983		
Lime	983	1036		
Blue Shale	1036	1039		
Hd. Blue Lime	1039	1087		
White Shale	1087	1102		
Hd. Lime	1102	1127		
Lime	1127	1130		
Hd. Lime	1130	1150		
Blue Shale	1150	1168		
Black Shale	1168	1195		
Shale	1195	1200		
Sand Lime	1200	1248		
Shale	1248	1260		
Lime Hd. & Gritty	1260	1268		
Lime	1268	1273		
Lime Hard	1273	1308		
Slate	1308	1323		
Slate	1323	1337		
Lime Sandy	1337	1348		
Blue Shale	1348	1356		
Hard Lime	1356	1360		
Slate	1360	1375		
Lime Hard	1375	1459		
Lime	1459	1484		
Red Rock	1484	1494		
Red Rock, Bk. Shale	1494	1506		
Lime	1506	1535		
Blue Shale	1535	1544		
Lime	1544	1562		
Blue Shale	1562	1576		
Blue Shale	1576	1642		
Lime	1642	1662		
Blue Slate	1662	1700		
TOTAL DEPTH				

STATE WHERE IN FORMATION BEST PRODUCTION WAS FOUND.



(over)

Sec. 11 Twp. 35s Range 1E

1 Strickland
Kansas Geological Society

Floyd O. Howarth
Skelly Scout Tickets

Form 252A SM 4-22 8765

Map No. _____ Sec. 11 Twp. 35S R. 1E

Well No. 1 Farm _____


Floyd O. Howarth Company _____

_____ Ft. from N. Line

_____ Ft. from S. Line

_____ Ft. from E. Line

_____ Ft. from W. Line

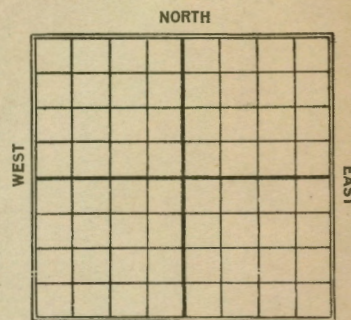

Taken from letter


Date	REPORT
<u>7/22</u>	
<u>9/26</u>	<u>Dlg. 1855' (Letter)</u>
<u>1923</u>	
<u>2/13</u>	<u>Dlg. 2800' (Tel)</u>
<u>2/17</u>	<u>3244 - Dlg. (Tel)</u>
<u>3/21</u>	<u>3600 - Well plug (Letter)</u>
	<u>A.G.W.</u>

No Good
Must have
Scout ticket
Sam

(29) MAP No. K1 SEC. 11 TWP. 35S R. 1E
 WELL No. 1 Strickland
Haworth & Co. COMPANY

CONTRACTOR

SECTION PLAT

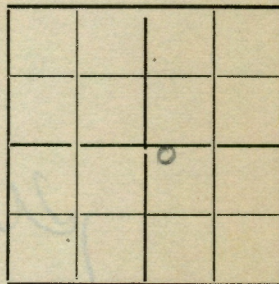

FT. FROM N. LINE

FT. FROM S. LINE

FT. FROM E. LINE

FT. FROM W. LINE

LOCATION

RIG UP

DRILLING AND REMARKS:

Top line
3130

6' @ 3250
How all 321
3250

RECORD

CASED _____ IN. _____ FT.

SAND _____

GAS _____

OIL _____

TOTAL DEPTH 2600

PRODUCTION

1ST 24 HRS. NAT. _____

1ST 24 HRS. AFTER SHOT _____

GAS _____ CU. FT.

DRY HOLE ☒ABANDONED ☒

DATE

Apr 3
 192 3

SCOUT

Map No. _____ Sec. 11 Twp. 35S R. 1E
 Well No. 1 Far _____
Floyd O. Howarth Company

NORTH

LOG

