


Section 6 Township 35 Range 1EWell No. #1 Milikin (Milligan)Company Hearndon Drlg.

NORTH

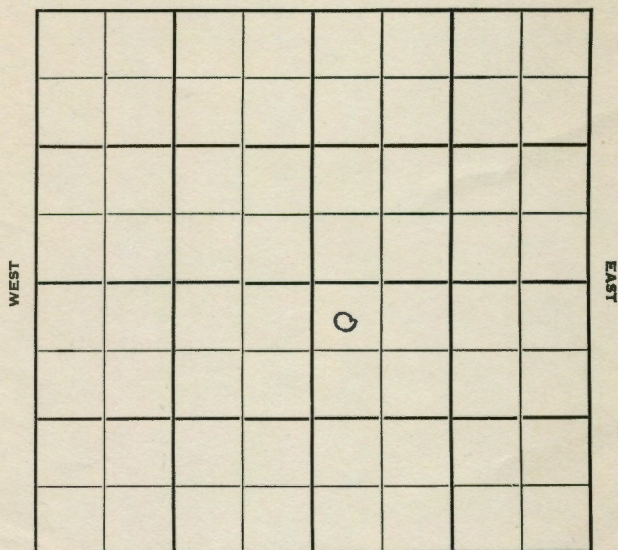

SOUTH

Sec. 6 Twp. 35 R. 1EWell No. #1 Milikin FarmHearndon Drlg. CompanyHearndon Drlg. Contractor

Gulph

330 Ft. from N. Line


Ft. from S. Line

Ft. from E. Line

330 Ft. from W. Line

NW NW SE

NORTH

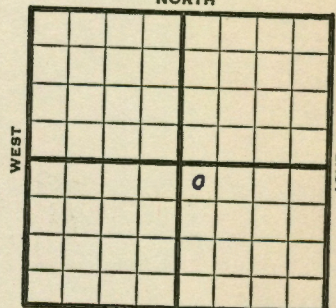

SOUTH

1952

Elev. 1144' REPORT

1/9

RUR

1/30

Spud 1-7-52

D&A TD 3970

8" @ 385 Miss 3665

DST 3694-99 opn 1 hr

Rec. 60' mud

Miss 3732

DST 3964-70 opn 1 hr.

Rec. 315' sw

TD 3970

D&A

ABANDONED

1952

O. W. D. D.

4/16

Miss 3732' Simp 3968'

OTD 3970' D & A

RUR To Drill to Arb.

4/23

D&A TD 4109'

Miss. 3732 Simp. 3968 OTD 3970

DD Arb. 4087 TD 4109 D&A

ABANDONED

County	Summer		State	Kansas	
Sec.	6	(Blk.) Twp.)	35	(Sur.) Rge.)	1E Map No.
Operator	Hearndon Drlg.				
Well No.	1	Farm	Milikin		
Elev.			Location	NW NW SE	

FIRST REPORT

330	Ft. From	N	Line	SE
330	Ft. From	W	Line	Quarter
1st. Report JAN 9 1962				
Completion				
Remarks				
Hearndon Drlg. - Contr.				
Spudding Date				

Drig. Data Gulph

RUR

J. E. TYRA

County	Sumner			State	Kansas
Sec.	6	(Blk.) (Twp.)	35	(Sur.) (Rge.)	1E
Map No.					
Operator	Herndon Drlg.				
Well No.	1	Farm	Milikin		
Elev.	1144	Location	NW NW SE		

TRANSFORM

330	Ft. From	N	Line	SE
330	Ft. From	W	Line	Quarter
1st. Report				
Completion JAN 30 1952				
Remarks Guelph Pool				
Herndon Drlg. - Contr.				
Spudding Date 1-7-52				

Drig. Data D & A TD 3970

8" @ 385 Miss. 3665 DST 3694-99
open 1 hr. Rec. 60' mud Miss. 3732
DST 3964-70 open 1 hr. Rec. 315' sw
TD 3970 D & A

J. G. McGEHEE