


Section 1 Township 35 Range 1 E
 Well No. #1 Ramp
 Company Alpine Oil & Royalty

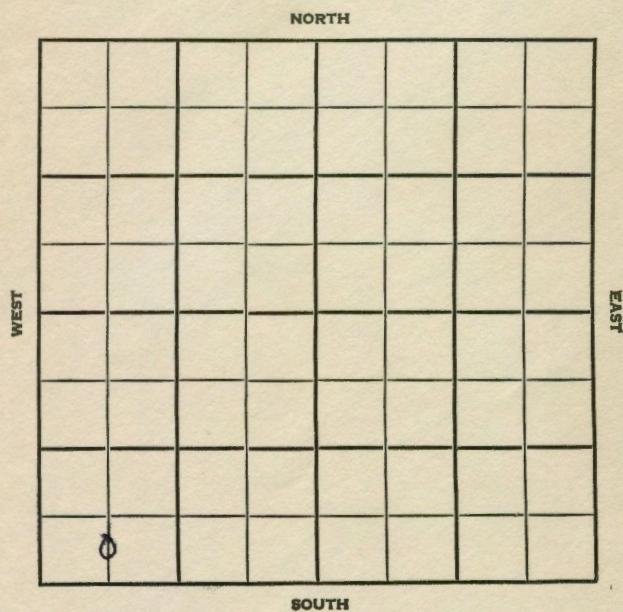

SEC. 1 TWP. 35 R. 1 E
 WELL NO. #1 Ramp FARM
 COMPANY Alpine Oil & Royalty
 CONTRACTOR

Ditter Creek

_____ Ft. from N. Line
 _____ Ft. from S. Line
 _____ Ft. from E. Line
 _____ Ft. from W. Line

C S $\frac{1}{2}$ SW SW

Stal Test

1955 ELEVATION 1114' REPORT

10/5 Loc

1956

1-11

Comm. 10-9-55
 8 5/8" @ 144/150
 5 1/2" @ 2364
 DD 2381
 5 mcfg
 Comp. SI gas well
 Stal. 2361
 TD 2381'

COMPLETED

County Sumner Elev. 1114
 Sec. 1 Twp. 35 Rge. 1E
 Company Alpine Oil & Royalty
 Farm Name Ramp No. 4

TOPS	DEPTH	LOG	DATUM	Loc. in Sec.
Anh.				C S $\frac{1}{2}$ SW SW
Tr.	<u>Stal</u>	<u>2.361</u>	<u>1247</u>	
Dg.				
Bl.				
L.				
K.C.				Geol.
B.K.C.				Contr.
Ce.				
C.				
M.				Pool
M.				Bitter Creek
K.				
Mz.				
Me.				
V.				
S.				
S.				
A.				
R.				
Pe.				
G.				
FD.	<u>2.364</u>			

Date Comm. 10-9-55 JAN 1 1 1956

8 5/8" @ 114/150 5 1/2" @ 2364 DD 2381

5 mcfg Comp. SI gas well

County Sumner Elev. 1114
 Sec. 1 Twp. 35 Rge. 1E
 Company Alpine Oil & Royalty
 Farm Name Ramp No. 4

TOPS	DEPTH	LOG	DATUM	Loc. in Sec.
Anh.				C S $\frac{1}{2}$ SW SW
Tr.				
H.				
Tr.				
Dg.				Stal. test
Bl.				
L.				Geol.
K.C.				Contr.
B.K.C.				
Ce.				
C.				
M.				Pool
M.				Bitter Creek
K.				
Mz.				
Me.				
V.				
S.				
S.				
A.				
R.				
Pe.				
G.				
FD.				

Date Comm.

Location

FIRST REPORT
OCT 5 55