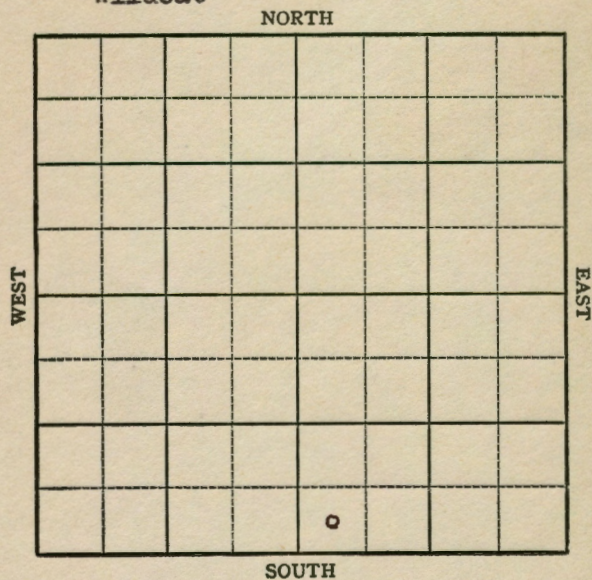


Section 2 Township 35 Range 1-EWell No. #1 OwenCompany T H Gilbert
WildcatSec. 2 Twp. 35 R. 1-EWell No. #1 Owen FarmT H Gilbert CompanyWildcat


Ft. from N. Line

330 Ft. from S. Line

Ft. from E. Line

330 Ft. from W. Line

SW SE

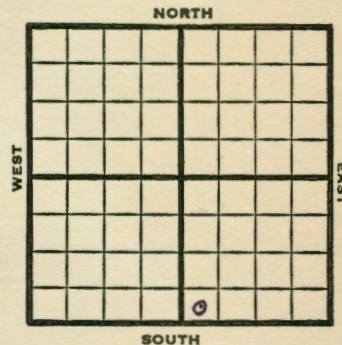

1948

Eli 1123'

REPORT

10/13 Location

10/19 "

10/26 8" @ 170'

Drlg. 751'

11/3 Stalnacker 2408'

Drlg 2827'

11/10 Miss 3507'Simp 3732

TD 3740'

Run csg.

11/16 5" @ 3728'

11/23 TD 3837'

Arb. 3829'

Aband.

ABANDONED

Map No. 1 Sec. 2 Twp. 35 R. 1EWell No. 1 OwenT. H. Gilbert CompanyABANDONED Contractor


SW SE

E1,123
SECTION PLAT

Ft. from N. Line

330 Ft. from S. Line

Ft. from E. Line

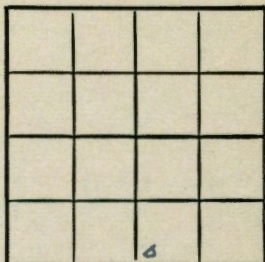330 Ft. from W. Line

Sumner County

Location

Rig up

Drilling and Remarks:

Box 3828

RECORD

Cased in, ft.

Sand

Gas

Oil

Total Depth 3827

PRODUCTION

1st 24 hrs. Nat.

1st 24 hrs. after shot

Gas Cu. Ft.

Dry Hole

Abandoned

Date

NOV 23 1948 19 S. J. LEWIS Scout

Map No. _____ Sec. 2 Twp. 35 R. 1EWell No. 1 OwenT. H. Gilbert CompanyFIRST REPORT Contractor


SW SE

SECTION PLAT

Ft. from N. Line

330 Ft. from S. Line

Ft. from E. Line

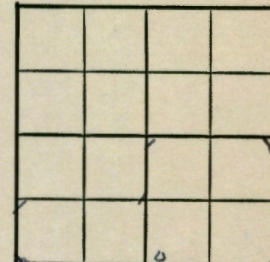330 Ft. from W. Line

Sumner County

Location X

Rig up

Drilling and Remarks:

RECORD

Cased in, ft.

Sand

Gas

Oil

Total Depth

PRODUCTION

1st 24 hrs. Nat.

1st 24 hrs. after shot

Gas Cu. Ft.

Dry Hole

Abandoned

Date

OCT 13 1948 19 S. J. LEWIS Scout