


Section 5 Township 35 Range 1 E

Well No. # 1 Hackney

Company Anderson-Prichard

NORTH

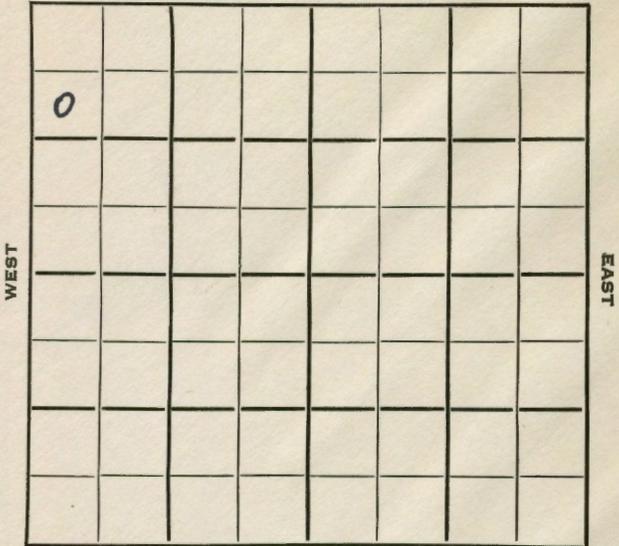

SOUTH

Sec. 5 Twp. 35 R. 1E

Well No. #1 Hackney Farm

Anderson-Prichard Company

Glenn Peel Contractor

**Guelph Pool**

990 Ft. from N. Line


\_\_\_\_\_ Ft. from S. Line

\_\_\_\_\_ Ft. from E. Line

330 Ft. from W. Line

SW NW NW

NORTH

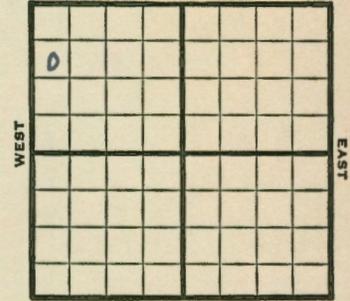

SOUTH

1953 **Elev. 1113'** REPORT

5/20 MIR

6/10 Spud 5-20-53 D & A TD 4030  
 8" @ 395 **Layton 3057**  
 DST 3038-88 open 1 hr rec 150' mud  
 180' SW **Oswego 3430 Miss 3714**  
**Simp. 4011**  
 DST 4005-30 open 1/2 hr rec 815' SW  
 1335# TD 4030 D & A

**ABANDONED**

County Sumner State Kansas

Sec. 5 (Blk. 35 (Sur. 1E (Twp. 35 Rge.) Map No.

Operator Anderson-Prichard

Well No. 1 Farm Hackney

Elev. \_\_\_\_\_ Location SW NW NW

0					

990 Ft. From N Line NW

330 Ft. From W Line Quarter

Ist. Report MAY 20 1953

Completion \_\_\_\_\_

Remarks \_\_\_\_\_

Glenn Peel - Contr.

Spudding Date \_\_\_\_\_

Drig. Data Guelph Pool

M I R

County Sumner State Kansas

Sec. 5 (Blk. 35 (Sur. 1E (Twp. 35 Rge.) Map No.

Operator Anderson-Prichard

Well No. 1 Farm Hackney

Elev. 1143 Location SW NW NW

0					

990 Ft. From N Line NW

330 Ft. From W Line Quarter

Ist. Report \_\_\_\_\_

Completion JUN 10 1953

Remarks Guelph Pool

Glenn Peel - Contr.

Spudding Date 5-20-53

Drig. Data D & A TD 4030

8" @ 395 Layton 3057 DST 3038-88

open 1 hr. Rec. 150' mud 180' sw

Oswego 3430 Miss. 3714 Simp. 4011

DST 4005-30 open 1/2 hr. Rec. 815' sw

1335# TD 4030

D & A

J. G. McGEHEE