

Section 6 Township 35 Range 1 E

Sec. 6 Twp. 35 R. 1 E


Well No. # 1 Gurley

Well No. # 1 Gurley Farm

Company Herndon Drlg.


Herndon Drlg. Company

Wildcat Contractor

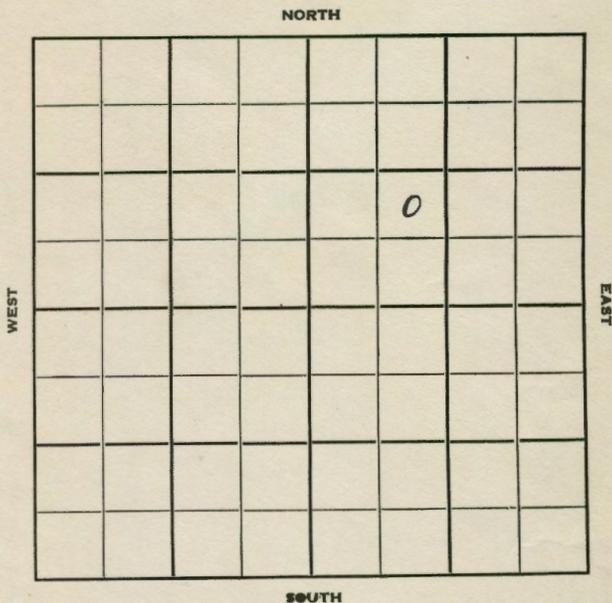

990 Ft. from N. Line
990 Ft. from S. Line
990 Ft. from E. Line
990 Ft. from W. Line

NE SW NE

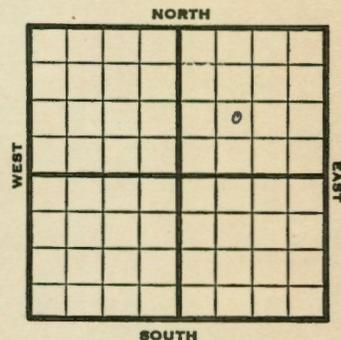

1951 **Lev. 1112'** REPORT

7/11 Drlg.

8/8 Oil well TD 3073'
Stal. 2627' Layton 2991' Sand 3026'
 DST 3030-53 open 45 min. rec 180' HO & GCM
 DST 3051-63 open 1/2 hr, rec 140' oil 30' O & GCM
 DST 3055-73 open 1 hr. rec 50' HO & GCM, 415' oil
 5" @ 3028' TD 3073' S/100 BO 8 hr.
 Comp. 87 BOPD

COMPLETED

County Sumner State Kansas
 Sec. 6 (Blk. Twp.) 35 (Sur. Rge.) 1E Map No.
 Operator Herndon Drilling
 Well No. 1 Farm Gurley
 Elev. 1112 Location NE SW NE

 990 Ft. From S Line NE
 990 Ft. From W Line Quarter
 Ist. Report JUL 11 1951
 Completion _____
 Remarks _____
 Spudding Date _____

Drlg. Data Wildcat
Drlg.

J. E. TYRA

County Sumner State Kansas
 Sec. 6 (Blk. Twp.) 35 (Sur. Rge.) 1E Map No.
 Operator Herndon Drlg.
 Well No. 1 Farm Gurley
 Elev. 1112 Location NE SW NE

 990 Ft. From S Line NE
 990 Ft. From W Line Quarter
 Ist. Report _____
 Completion AUG 8 1951
 Remarks Wildcat
 Spudding Date _____

Drlg. Data Oil well TD 3073
 Stal. 2627 Layton 2991 Sand 3026
 DST 3030-53 open 45 min. Rec. 180' ho
 & gcm DST 3051-63 open $\frac{1}{2}$ hr. Rec.
 140' oil 30' o & gcm DST 3055-73
 open 1 hr. Rec. 50' ho & gcm 415' oil
 5" @ 3028 TD 3073 S/ 100 bo 8 hr.
 Comp. 87 bopd

J. E. TYRA