
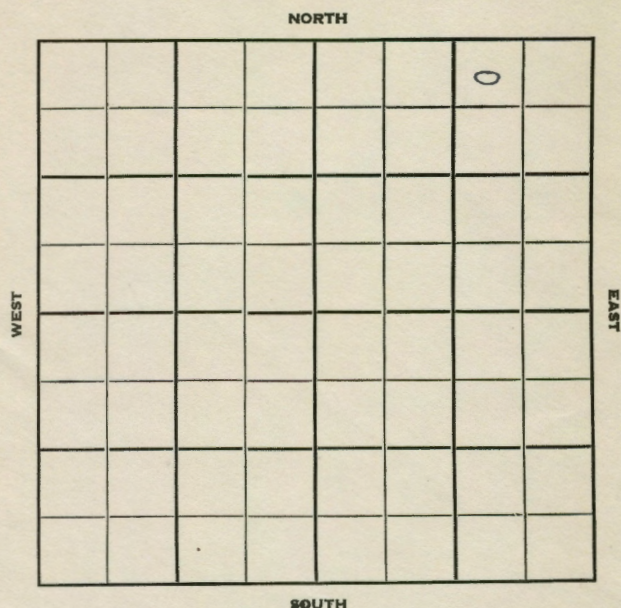


Section 6 Township 35 Range 1EWell No. #6 GurleyCompany Hearndon Drlg.Sec. 6 Twp. 35 R. 1EWell No. #6 Gurley FarmHearndon Drlg. CompanyHearndon ContractorGuelph330 Ft. from N. Line Ft. from S. Line990 Ft. from E. Line Ft. from W. Line

NW NE NE

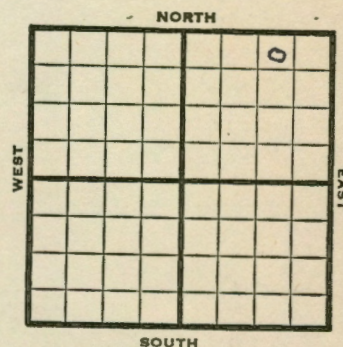

1952

Elev. 1105

REPORT

1/23

Spud 1-20-52
Drlg. 239'

2/6

Drlg. 3607

Lay 3020 Miss 3605

2/13

Simp Sd 3883 TD 3902
5" @ 3884 Drlg. plug

2/20

NR

2/27

Spd 1-20-52
Oil Well TD 3902
8" @ 365Layton 3020 Miss 3605
Dol. 3607 Simp 3883

TD 3902 5" @ 3884

Comp. 1949 bopd

COMPLETED

County Sumner State Kansas
 Sec. 6 (Blk. 35 (Sur. 1E Map No.
 Operator Hearndon Drlg.
 Well No. 6 Farm Gurley
 Elev. _____ Location NW NE NE

FIRST REPORT
 330 Ft. From N Line NE
 990 Ft. From E Line Quarter
 1st. Report JAN 23 1952
 Completion _____
 Remarks _____
Hearndon - Contr.
 Spudding Date 1-20-52
 Drlg. Data Guelph
Drlg. 239

J. E. TYRA

County Sumner State Kansas
 Sec. 6 (Blk. 35 (Sur. 1E Map No.
 Operator Herndon Drlg.
 Well No. 6 Farm Gurley
 Elev. 1105 Location NW NE NE

COMPLETE
 330 Ft. From N Line NE
 990 Ft. From E Line Quarter
 1st. Report _____
 Completion FEB 27 1952
 Remarks Guelph Pool
Herndon Drlg. - Contr.
 Spudding Date 1-20-52
 Drlg. Data Oil well TD 3902
8" @ 365 Layton 3020 Miss. 3605
Dol. 3607 Simp. 3883 TD 3902
5" @ 3884 Comp. 1949 bopd

J. G. McGEHEE