

Sumner


KANSAS

Section 6 Township 35 Range 1E

Well No. #1 Austin

Company Herndon Drlg.

NORTH

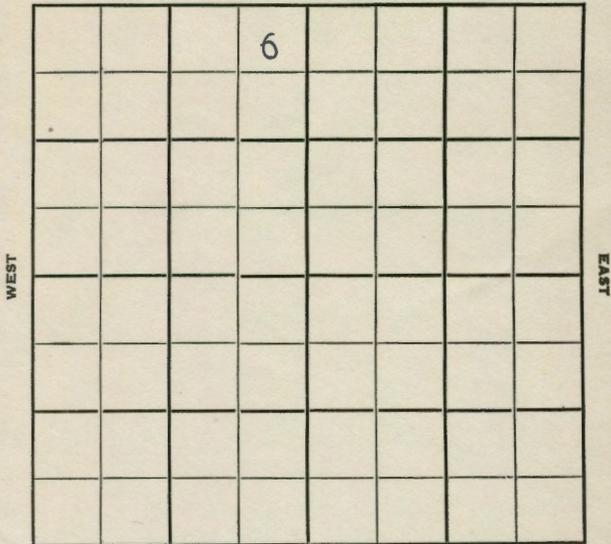

SOUTH

Sumner

KANSAS

Sec. 6 Twp. 35 R. 1E

Well No. #1 Austin Farm

Herndon Drlg. Company

Herndon Drlg. - Contr. Contractor

Guelth Pool

330' Ft. from N. Line


_____ Ft. from S. Line

330' Ft. from E. Line

_____ Ft. from W. Line

NE NE NW

NORTH

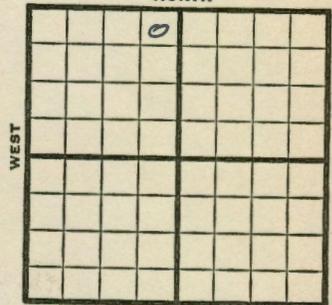

SOUTH

1951 **Elev. 1094'** REPORT

10/24 Spud 10-21-51
8" @ 375
WOC

1952
1/9 Spud 10-21-51
Oil well T^u 3872
8" @ 375
Simp. 3855 TD 3872
5" @ 3855 CO to 3872
F/ 50 BOPH 2 hr. F/ 60 BOPH 2 hr.
Comp. BHB 3000 BOPD

COMPLETED

