

Sumner

KANSAS

Sec. 6 Twp. 35 R. 1E

Well No. #2 Austin Farm

Herndon Drlg. Company

Herndon Drlg. Contractor

Ft. from N. Line

330


Ft. from S. Line

990

Ft. from E. Line

Ft. from W. Line

SW SE NW

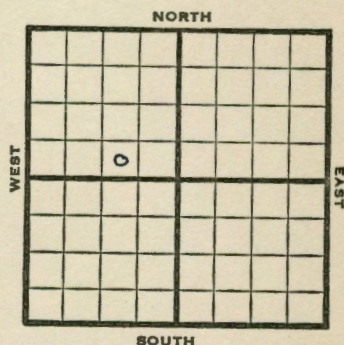

1951

Elev. -

REPORT

11/28

Location

12/12

Abandoned Location

ABANDONED


Sumner

KANSAS

Section 6 Township 35 Range 1E

Well No. #2 Austine

Company Herndon Drlg.

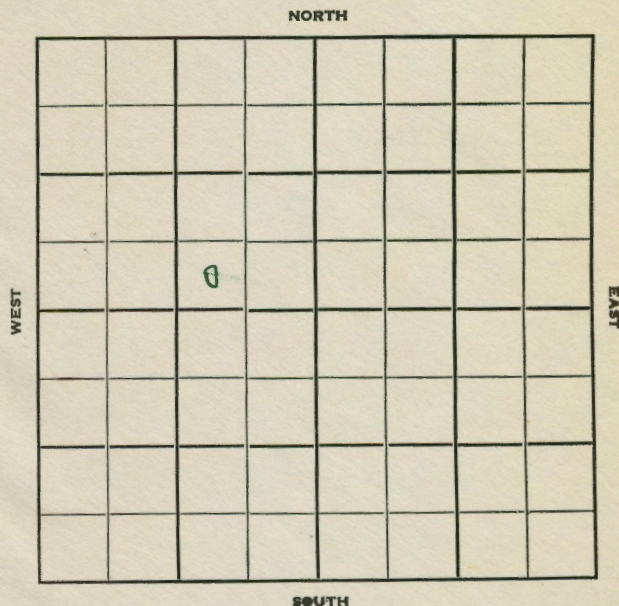

County Sumner State Kansas
 Sec. 6 (Bk. 35 (Sur. 1E Map No.
 (Twp.)
 Operator Herndon Drlg.
 Well No. 2 Farm Austin
 Elev. Location SW SE NW
 330 Ft. From S Line NW
 990 Ft. From E Line Quarter
 1st. Report NOV 28 1951
 Completion
 Remarks
Herndon Drlg. - Contr.
 Spudding Date

FIRST REPORT

Drlg. Data

Location

J. E. TYRA

County Sumner State Kansas
 Sec. 6 (Bk. 35 (Sur. 1E Map No.
 (Twp.)
 Operator Herndon Drlg.
 Well No. 2 Farm Austin
 Elev. Location SW SE NW
 330 Ft. From S Line NW
 990 Ft. From E Line Quarter
 1st. Report
 Completion DEC 12 1951
 Remarks
Herndon Drlg. - Contr.
 Spudding Date

BANDONED

Drlg. Data

Abd. location

J. E. TYRA