


KANSAS

Section 6 Township 35 Range 1E

Well No. #2 Austin

Company Hearndon Drlg.

NORTH

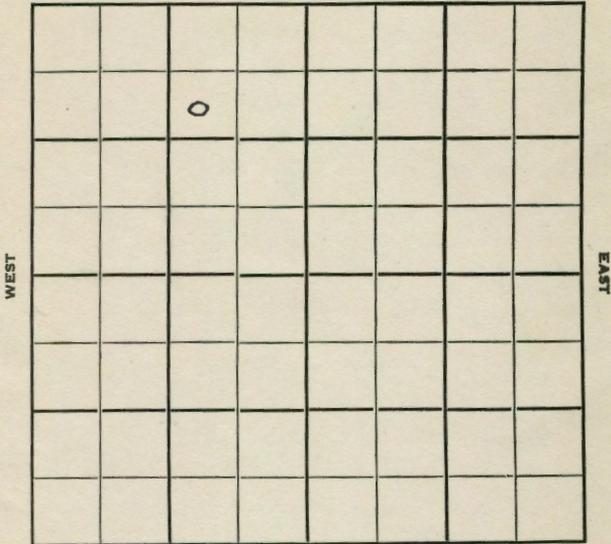

SOUTH

Summer KANSAS

Sec. 6 Twp. 35 R. 1E

Well No. #2 Austin Farm

Hearndon Drlg. Company

Gulph

990 Ft. from N. Line


Ft. from S. Line

990 Ft. from E. Line

Ft. from W. Line

SW NE NW

NORTH

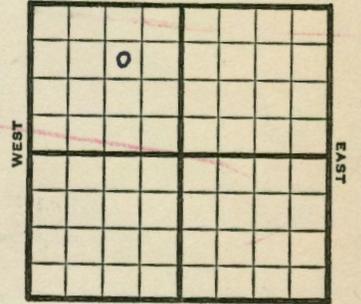

SOUTH

1952 **Elev. 1088'** REPORT

1/9 RUR
 2/6 TD 4000 D&A
 2/13 D&A TD 3972
 8" @ 358
 Layton 3016 Peru 3030
 Miss 3660 Kh 3905
 Simp 3968 TD 3972
 D&A

ABANDONED

