


Section 6 Township 35 Range 1E

Well No. #3 Austin

Company Herndon Drlg.

NORTH

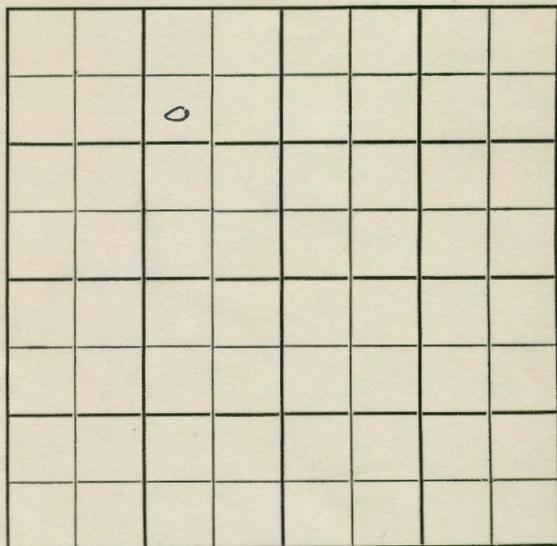

SOUTH

Sec. 6 Twp. 35 R. 1E

Well No. #3 Austin Farm

Herndon Drlg. Company

Contractor

Gulph


990 Ft. from N. Line

Ft. from S. Line

330 Ft. from E. Line

Ft. from W. Line

SE NE NW

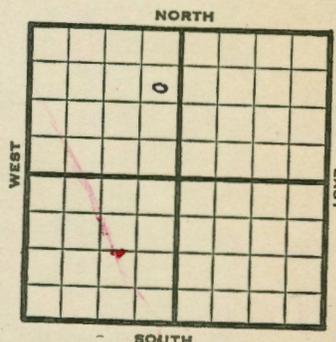

1952 **Elev. 1090'** REPORT

- 3/5 8" @ 350'  
Drlg. 2000
- 3/12 Drlg. 3 390'
- 3/19 **Miss li 3570' Meisner 3833'**  
**Simp. 3835'**  
DST 3866-77', 2½ hrs, 800' oil, 60'  
OCM, 1475#-15"
- 3/25 No report
- 4/1 **Arb. 3955'** RTD 3974' 5" @ 3956'  
WOC
- 4/9 DD to 4002 TD 1000 A oil & wtr.
- 4/23 B/1 BO & 6 BWPh PB 3880 60/3860-75  
F 50 BOPH for 2 hrs.
- 4/30 Oil Well TD 4002' 8" @ 350'  
**Miss Li 3570 Misener 3833**  
**Simp. 3835**  
DST 3866-77 open 2½ hr. rec. 800' oil  
60' ocm  
**Arb. 3955** TD 3974 5" @ 3956  
DD 4002 1000 A oil & wtr.  
B/ 1 bo 6 bwph PB 3880 60/ 3860-75  
F/ 50 boph Comp. 1629 bopd

**COMPLETED**

