


Section 6 Township 35 Range 1E

Well No. 2 Gurley

Company Herndon Drlg.

NORTH

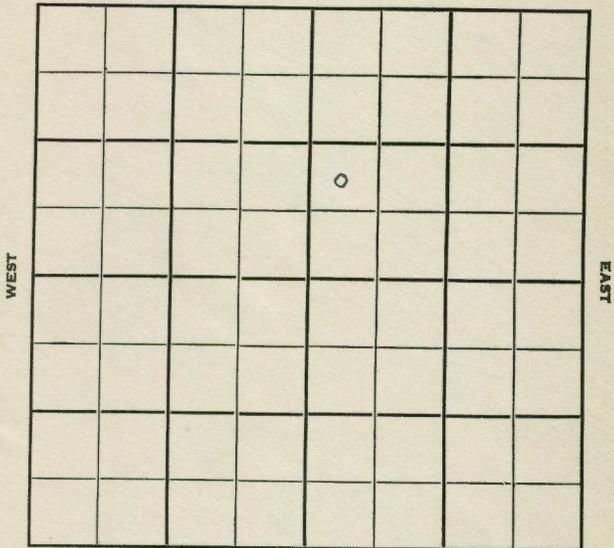

SOUTH

Sec. 6 Twp. 35 R. 1E ✓

Well No. #2 Gurley Farm

Herndon Drlg. Company

Contractor

\_\_\_\_\_ Ft. from N. Line


990' Ft. from S. Line

\_\_\_\_\_ Ft. from E. Line

330' Ft. from W. Line

NW SW NE

NORTH

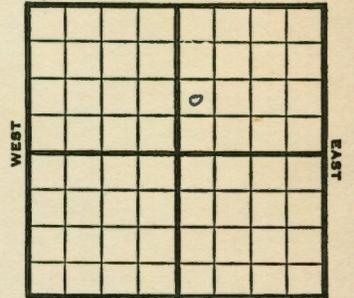

SOUTH

1951 **Elev. 1099'** REPORT

7/25 Spud 7-21-51  
8" @ 425  
WOC

8/29 Spud 7-21-51  
Oil well TD 3860' 8" @ 425  
**Layton 2965' Layton sand 3007'**  
DST 3053-73 open 1 hr. rec 125' SW  
**KC 3170' Penn. sd 3280'**  
**Oswego 3347' Cherokee 3477'**  
**Miss. 3606' Simp. 3836' Kh. 3793'**  
DST 3853-60 open 1½ hr. gas in 7 min.  
Flow in 37 min. rec 1620' oil, 90'  
OCM 5" @ 3854' TD 3860'  
F/48 BOPH  
Comp. BHB 2039 BOPD

**COMPLETED**

