

WELL COMPLETION REPORT AND DRILLER'S LOG

KANSAS
State Geological Survey
WICHITA BRANCH

S. 7 T. 35S R. 2E E W


SEP

API No. 15 — 191 — 20966
County Number

Loc. SW NW

County Sumner

640 Acres
N

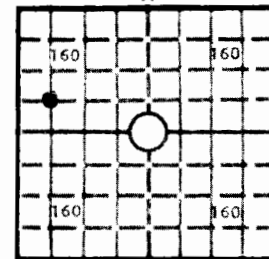

Elev.: Gr. _____

DF _____ KB _____

Operator Chase Exploration Corporation			
Address 2300 Philtower Building Tulsa, Ok. 74103			
Well No. 1-7	Lease Name Keefe		
Footage Location 660 feet from (X) (S) line 660 feet from (X) (W) line NW 1/4			
Principal Contractor B & N Drilling		Geologist	
Spud Date 9/27/79	Date Completed 10/1/79	Total Depth 952	P.B.T.D.
Directional Deviation		Oil and/or Gas Purchaser	

CASING RECORD

Report of all strings set — surface, intermediate, production, etc.

Purpose of string	Size hole drilled	Size casing set (in O.D.)	Weight lbs/ft.	Setting depth	Type cement	Sacks	Type and percent additives
SURFACE	12 1/8	8 5/8	28#	105	Common	120	3% CaCl
PRODUCTION	6 3/4	4 1/2	9.5#	947	Common	140	18% salt, 4% gel, 2% CaCl

LINER RECORD

PERFORATION RECORD

Top, ft.	Bottom, ft.	Sacks cement	Shots per ft.	Size & type	Depth interval

TUBING RECORD

Size	Setting depth	Packer set at			

ACID, FRACTURE, SHOT, CEMENT SQUEEZE RECORD

Amount and kind of material used	Depth interval treated

INITIAL PRODUCTION

Date of first production		Producing method (flowing, pumping, gas lift, etc.)			
RATE OF PRODUCTION PER 24 HOURS	Oil	Gas	Water	Gas-oil ratio	
	bbls.	MCF	bbls.	CFPB	
Disposition of gas (vented, used on lease or sold)			Producing interval (s)		

INSTRUCTIONS: As provided in KCC Rule 82-2-125, within 90 days after completion of a well, one completed copy of this Drillers Log shall be transmitted to the State Geological Survey of Kansas, 4150 Monroe Street, Wichita, Kansas 67209. Copies of this form are available from the Conservation Division, State Corporation Commission, 245 No. Water, Wichita, Kansas 67202. Phone AC 316-522-2206. If confidential custody is desired, please note Rule 82-2-125. Drillers Logs will be an open file in the Oil and Gas Division, State Geological Survey of Kansas, Lawrence, Kansas 66044.

Operator Chase Exploration Corporation		DESIGNATE TYPE OF COMP.: OIL, GAS, DRY HOLE, SWDW, ETC.:
Well No. 1-7	Lease Name Keefe	
S <u>7</u> T <u>35</u> S R <u>2</u> E ^E W		


WELL LOG

Show all important zones of porosity and contents thereof; cored intervals, and all drill-stem tests, including depth interval tested, cushion used, time tool open, flowing and shut-in pressures, and recoveries.

SHOW GEOLOGICAL MARKERS, LOGS RUN, OR OTHER DESCRIPTIVE INFORMATION.

FORMATION DESCRIPTION, CONTENTS, ETC.	TOP	BOTTOM	NAME	DEPTH
soil	0	11	No open hole logs run due to hole conditions.	
clay	11	26		
lime	26	242		
shale	242	612		
lime	612	628		
shale	628	681		
lime	681	740		
red bed	740	795		
shale	795	825		
lime	825	879		
shale	879	886		
lime	886	892		
shale	892	898		
lime	898	908		
shale	908	913		
lime	913	952		

USE ADDITIONAL SHEETS, IF NECESSARY, TO COMPLETE WELL RECORD.

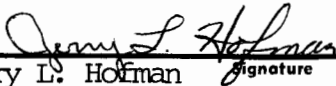Date Received	 Jerry L. Holman Senior Staff Engineer Title 9-24-81 Date
---------------	---