

Plotted


X
66' 16

BRADFIELD #1
NE 1/4 SE 1/4 SEC. 16-35-2E.,
SUMNER COUNTY, KANSAS.
Elev. 1134

Soil	4	Lime and shale	1469
Shale	80	Shale	1526
Lime	100	Sand-salt	1550
Shale	120	Bl. shale	1561
Lime	140		
Shale	150		
Lime	180		
Shale	220	Top first sand	1525'
Lime	245	Bottom of sand	1550'
Shale	295		
Lime	320		
Shale	330		
Red rock	345		
Lime	355		
Shale	400		
Lime	460		
Red shale	480		
Lime	490		
Red rock	505		
Lime	520		
Red rock	540		
Lime	550		
Red rock	560		
Shale	570		
Lime	580		
Shale	600		
Lime	610		
Red rock	630		
Shale	640		
Lime	645		
Red rock	655		
Lime	670		
Shale	680		
Red rock	695		
Lime	715		
Shale	745		
Sand	749		
Red shale	780		
Lime	800		
Sandy lime	805	Water	
Shale	835		
Lime	840		
Shale	880		
Lime	895		
Shale	915		
Lime	920		
Shale	935		
Lime	945		
Shale	1185		
Lime	1205		
Shale	1245		
Lime	1275		
Shale	1315		
Lime	1320		
Red shale	1340		
Lime	1355		
Red shale	1365		
Shale	1405		
Lime	1415		
Shale	1449		
Lime	1459		
Shale	1464		

Kansas Bradfield # 1

Sec. 16 Twp. 35 Rge. 2
 Farm No. _____
 _____ Company
 Elev. _____ T. D. _____
 Log No. 7436

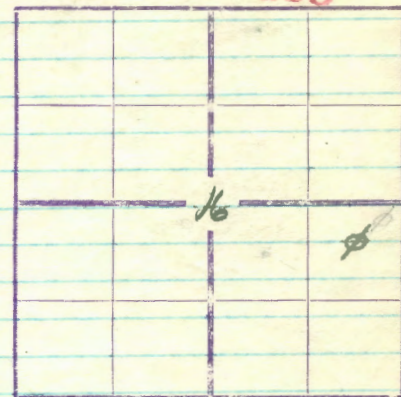

Soil	4
Lime	9
Sh	80
Lime	100
Sh	120
Lime	140
Sh	150
Lime	180
Sh	220
Lime	245
Sh	295
Lime	320
Sh	330
RR	345
Lime	355
Sh	400
Lime	460
R. Sh.	480
Lime	490
RR	505
Lime	520
RR	540
Lime	550
RR	560
Sh	570
Lime	580
Sh	600
Lime	610
RR	630
Sh	680
Lime	695
RR	695
Lime	670
Sh	680
RR	695
Lime	715
Ch.	745
Sd	749
R. Sh.	780
Lime	800
Sdy Lime	805 water
Sh. wh.	835
Lime	840
Sh	880
Lime	895
Sh	915
Lime	920
Ch.	935
Lime	945
Sh	1185

Lime	1205
Sh	1245
Lime	1275
Sh	1315
Lime	1320
R. Sh.	1340
Lime	1355
R. Sh.	1385
Sh. black	1405
Lime	1415
Sh	1449
Lime	1459
Sh. white	1464
Lime Sh.	1469
Sh	1526
Sand salt	1550
Clay black	1561

H.F.W. 1533, No gas

Top of first sand 1526
 Bottom " " " " 1550

Location 600' from N. line of quarter 5.
 600' " " W. " " " " " "